

MISSISSIPPI DEPARTMENT OF NATURAL RESOURCES
 Bureau of Land and Water Resources
 Southport Mall
 P.O. Box 10631
 Jackson, Mississippi 39209
WATER WELL DRILLERS LOG

CODED

Ø 24
 MARION

3-26-85 Griner Drilling Service, INC.

Marion

date well completed

firm name

county well located

LANDOWNER:

David New Drilling
 P.O. Drawer 1487
 Natchez, MS. 39130
 (mailing address)

description of formations encountered	from	to
gravel, sand	0	50
clay, breaks of sand	50	504
sand, p. gravel	504	640

WELL LOCATION: 425° 54' 38.50" E

sec. 20 T. 20 N. R. 14 E of NW/4
 No. 6 62.5 UNK #2 miles (distance) of Hub Field (direction) of (nearest town)

WELL PURPOSE: oilfield supply
 (home, irrigation, municipal, industrial)

WELL COMPLETION DATA:

- (1) diameter (inches) 3"
- (2) total depth (feet) 640'
- (3) static water level (feet) flowing above top of ground.
- (4) casing steel 640' (material), (depth)
 3" (size) if telescope see back.
- (5) screen 42 598' (length), (depth to top)
 3" perforated (size), (material)
- (6) pump — 150 (HP), (yield gpm)
 AC (type power)
- (7) electric log (yes or no)
 (organization running log)
- (8) how well bottom plugged Orange peel


DRILLERS REMARKS:

RECEIVED
 APR 2 - 1985

Department of Natural Resources
 Bureau of Land & Water Resources

If well telescopes please sketch and show depths.

GROUND LEVEL

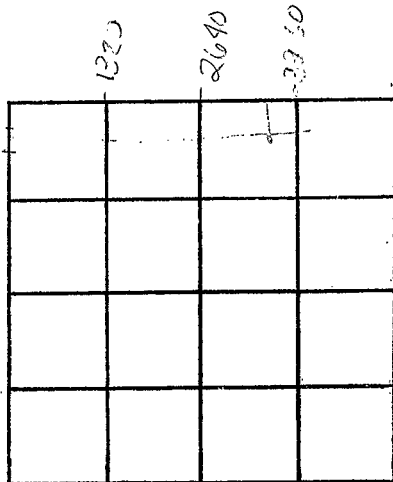

SECTION _____

Please indicate well location X.

ADDITIONAL INFORMATION

If more than one screen,
show locations of each on sketch.