	State Well Report	t For Office Use Only:	
County: Marion	Part 1	For Onice Ose Omy.	
	Mississippi Department of Environme	ental Quality Aquifer:	
Permit #:	Office of Land and Water Reso	well #: <u>Q-58</u>	
Driller: Gary Rayborn	P.O. Box 10631		
	Jackson, MS 39289-0631	L. S. Elevation:	
Date drilling completed: 2-13-07	(601)961-5210	E-log #:	
	(601)354-6938 (fax)	E-10g #.	
State Law requires that this rep 30 days of completion of drilling	ort be prepared by the driller in deta g of the well.	ail and filed with the Department within	
Well Owner Inform	ation	Well Location	
Dwner Name D+DDrillin	9, Inc Latitude: <u>31</u>	<u>• C8 '04</u> " Longitude: <u>87 • 49 · 23</u> "	
Mailing Address: P.D. Box	<u>634</u> Method of La	Method of Lat/Long (circle one): Conventional Survey,	
	USGS q	uad, Hand-held GPS, Survey-grade GPS	
Ferriday LA City St	<u>+ ΠΙ334</u> ate Zip Code <u>SE 14 SE</u>	<u>SE 14 SE 14 Sec 18 Twn ZN Rng 14E</u>	
City Telephone No. (318) 757-3		es of Fox worth	
	Well Data		
		Fish Culture Other: Rig Supply	
	Date well drilling cor		
If flowing, method of flow regulation: V	alve Other (describe)	·	
Static Water Level: <u>15</u> feet a	bove of below (circle one) land surface	Date measured: $2 \cdot 3 \cdot 0^{1}$	
Method of Measurement (circle one)	steel tape electric tape air line	other:	
Hole depth: 30 Well d	epth: <u>\$0</u> Well groute	d to a depth offeet	
Type of grout (circle one): Cement	Bentonite Mix		
	ing diameter: <u> </u>		
Screen length: 20 feet Scr	een diameter: <u> </u>	ype of screen: \underline{PVC}	
	Setting depth: From		
Type of completion (circle all applicable)	Gravel packed Underreamed Tele	scoped Open hole Natural Development	
	Other (describe):		
Top of lap pipe or reduction in casing:	feet. If telescoped or me	ore than one screen, describe on back of page	
Logs run (circle all applicable): No log r	un] Electrić Gamma Ray Density So	nic Neutron Other:	
Name of organization running log(s):			
I certify that the well was drilled, const	ructed, and completed in accordance wit	h all applicable requirements of the Mississippi	
Department of Environmental Quality	and/or the Mississippi Department of He	alth regulations and state laws.	
RAYCORN DRILLING, INC.	O - lo O		
1			

•

If well telescopes please sketch below and show depths.


Ground Level

Description of Formations Encountered	From	To
 Sand	0	20
Sand Goanse Sond Per Gravel	20	40 80
		<u> </u>
		1

p-58

If more than one screen, show location of each on sketch

Sketch the property layout and include the following: 1) the well location; 2) any permanent structures on the property that may aid in locating the well; 3) any roads, power lines, or other items that may aid in locating the property and the well;
4) indicate direction.

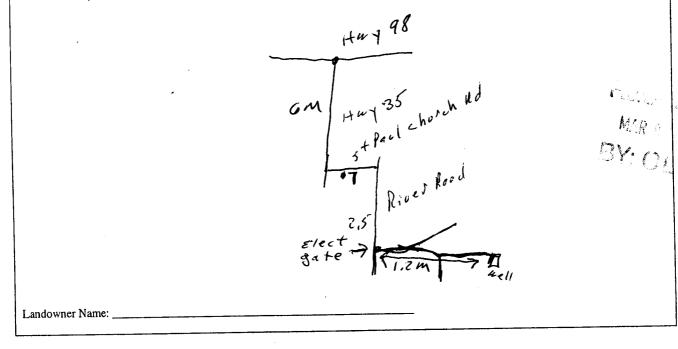

Signature of Water Well Contractor

			ELL REPORT Part 2	For Office Use Only:	
County: Marion		Pump Installer's Completion Report Mississippi Department of Environmental Quality		Aquifer:	
Permit #:		P.O.	and Water Resources Box 10631	Well #: Q-58	
Driller: Cary Ra			MS 39289-0631)961-5210		
Date completed: <u>2-13</u>		(601)3	54-6938 (fax)	Elevation:	
installation of num).		ail and filed with the Departme		
Well Owner Information		We	Well Location		
Owner Name: D+ D Drilling Inc		Latitude: Longitude:			
Mailing Address: P.O.Box 1634			Method of Lat/Long (circle one): Conventional Survey,		
				d-held GPS, Survey-grade GPS	
Ferriday LA 71334 City State Zip Code		1414 Sec	1414 Sec_18Twn 2N_Rng_14E		
City	Sta	te Zip Code	Distance Direction	Nearest Town	
Telephone No. (<u>318)</u>	757-3	274	Miles	of Foxworth	
Ритр Туре		Power Type Circle one			
	Circle one				
Air Lift	Jet	Submersible	Diesel Engine Gasol	line Engine Natural Gas	
Bucket	Piston	Turbine	Electric Motor Hand		
Centrifugal	Rotary	Flowing Well		r (specify):	
Other (specify):				or: <u>5</u>	
Date Pump Installed: 213-07		Setting Depth:	feet		
Rated Pump Capacity: _	60	Gallons Per Minute	Number of Stages:	14	
		·····		MARC:	
Pump Test Data		Method of N	Aeasuring Water Level , Circle one		
Date Well Tested:	2-13	-07	Air Line Electric M	leasuring Line Steel Tape	
Static Water Level (A):		Feet Below Land Surface	l	<u> </u>	
	B):I	Feet Below Land Surface			
Pumping Water Level (Feet Below Land Surface		shut in head:fee	
Pumping Water Level (Drawdown [(B) – (A)]:				(ID) (with a drawdown of	
	1.0			GPM with a drawdown of	
Drawdown [(B) – (A)]: Test Pumping Rate:	60			GPM with a drawdown of	

<u>Frint Name of Pump Installer and License No. (if applicable)</u>

Signature of Pump Installer