

Marion
 2000
 Feb. 76

MISSISSIPPI
 BOARD OF WATER COMMISSIONERS
 416 North State Street
 Jackson, Mississippi 39201

WATER WELL DRILLERS LOG

Feb. 1976 E.B. Sheppard Marion
 date well completed firm name county well located


LANDOWNER:	description of formations encountered	from	to
<u>August Jerry</u>	<u>GRAY CLAY</u>	<u>0</u>	<u>20'</u>
<u>Columbia, Miss.</u>	<u>SAND + GRAVEL</u>	<u>20</u>	<u>40'</u>
(mailing address)	<u>BLUE CLAY</u>	<u>40</u>	<u>160'</u>
WELL LOCATION:	<u>SAND + PEA GR</u>	<u>160</u>	<u>240'</u>
sec. <u>14</u> T <u>2</u> N <u>18</u> E	<u>BLUE CLAY</u>	<u>240</u>	<u>500'</u>
<u>8 1/4</u> miles <u>SE</u> of <u>Columbia</u>	<u>FINE SAND</u>	<u>500</u>	<u>540'</u>
(distance) (direction) (nearest town)	<u>COARSE SAND + PEA</u>		
WELL PURPOSE:	<u>GRAVEL</u>	<u>540</u>	<u>607'</u>
(home, irrigation, municipal, industrial)			
WELL COMPLETION DATA:			
(1) diameter (inches) <u>2"</u>			
(2) total depth (feet) <u>607</u>			
(3) static water level (feet) <u>5</u> below top of ground.			
(4) casing <u>pl. 572'</u> (material) (depth)			
<u>2"</u> (size) If telescope see back.			
(5) screen <u>35'</u> (length) (depth to top)			
<u>2"</u> (size) <u>pl.</u> (material)			
(6) pump <u>no pump</u> (HP) <u>50</u> (yield gpm)			
<u>water</u> (type power) <u>flow well</u>			
(7) electric log (yes or no) <u>(no)</u>			
(organization running log)			
(8) how well bottom plugged <u>B.W.V.</u>			
DRILLERS REMARKS:			

RECEIVED
 OCT 18 1976

MISS. BD. OF WATER COMMISSIONERS

If well telescopes please sketch and show depths.

GROUND LEVEL

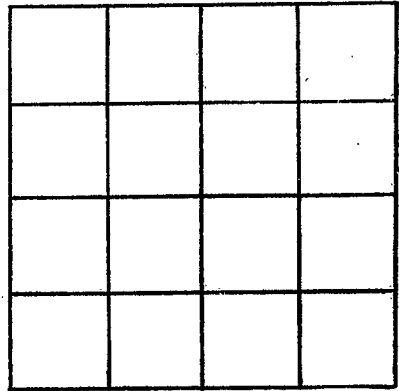

SECTION _____

Please indicate well location X.

ADDITIONAL INFORMATION

If more than one screen, show locations of each on sketch.