

Marion  
 # 2001  
 2/11/77

MISSISSIPPI  
 BOARD OF WATER COMMISSIONERS  
 416 North State Street  
 Jackson, Mississippi 39201

WATER WELL DRILLERS LOG

2/11 1977 Hollinsworth Well Marion  
 date well completed firm name county well located

LANDOWNER: <u>F.A. VARNADO</u>	description of formations encountered	from	to
<u>Rt 2</u>			
<u>Foxworth, Miss</u> (mailing address)	<u>Clay, Chalk</u>	<u>0</u>	<u>12</u>
	<u>SAND, GRAVEL</u>	<u>12</u>	<u>50</u>

WELL LOCATION:  
 sec. 7 T. 20N S. R. 18E  
1/2 miles IN of Cherwell  
 (distance) (direction) (nearest town)

WELL PURPOSE: Home  
 (home, irrigation, municipal, industrial)


- WELL COMPLETION DATA:
- (1) diameter (inches) 2"
  - (2) total depth (feet) 50
  - (3) static water level (feet) 8 below above top of ground.
  - (4) casing PVC (material) (depth) \_\_\_\_\_  
 (size) if telescope see back.
  - (5) screen 5 45 (length) (depth to top)  
2" PVC (size) (material)
  - (6) pump 1/2 9 (HP) (yield gpm)  
elect (type power)
  - (7) electric log \_\_\_\_\_ (yes or no)  
 (organization running log)
  - (8) how well bottom plugged sand 3 HARI

DRILLERS REMARKS: very good

**RECEIVED**  
 MAR - 7 1977  
 MISS. BD. OF WATER COMMISSIONERS

If well telescopes please sketch and show depths.

GROUND LEVEL

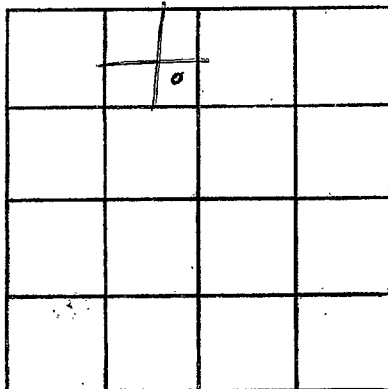

SECTION 7

Please indicate well location X.

ADDITIONAL INFORMATION

If more than one screen, show locations of each on sketch.