

MARION
0
8-31-78
2002

MISSISSIPPI
BOARD OF WATER COMMISSIONERS
416 North State Street
Jackson, Mississippi 39201

WATER WELL DRILLERS LOG

8/31 1978 Hollinger Well S. MARION
date well completed firm name county well located

LANDOWNER: Fred Nearsquad
Rt 3 Box 94 D-1
Forworth MS
(mailing address)

description of formations encountered	from	to
CLAY, GRAVEL	0	40
CHALK	40	100
fine sand	100	140
pebbles	140	180

WELL LOCATION:
sec 15 T 2 N R 18 E
5 miles W of Cherokee
(distance) (direction) (nearest town)

WELL PURPOSE: Home
(home, irrigation, municipal, industrial)

- WELL COMPLETION DATA:
- (1) diameter (inches) 4"
 - (2) total depth (feet) 180
 - (3) static water level (feet) 100 below top of ground
 - (4) casing PVC, 170 (material) (depth)
 - (size) if telescope see back.
 - (5) screen 10ft, 170 (length) (depth to top)
 - 4" PVC (size) (material)
 - (6) pump 1 (HP) 14 (yield gpm)
 - elect (type power)
 - (7) electric log (yes or no)

(organization running log)
(8) how well bottom plugged sand SHARK


DRILLERS REMARKS: Very good well

RECEIVED
OCT 12 1978

MISS. BD. OF WATER COMM

If well telescopes please sketch and show depths.

GROUND LEVEL

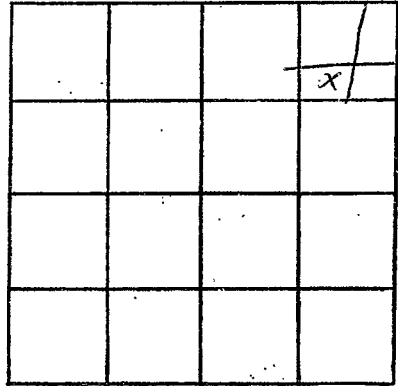

SECTION 15

Please indicate well location X.

ADDITIONAL INFORMATION

If more than one screen,
show locations of each on sketch.