

Marion
2004

MISSISSIPPI
BOARD OF WATER COMMISSIONERS
416 North State Street
Jackson, Mississippi 39201

12-21-79

WATER WELL DRILLERS LOG

12-21 1979 Hollinger Marion
date well completed firm name county well located

LANDOWNER: R. J. Hollinger
RT 2
Topworth, MS
(mailing address)

description of formations encountered	from	to
gravel, chalk	0	20
pen gravel	20	40

WELL LOCATION:
sec. 30 T 2 N R 1 E S 14 E
1 miles E of Marion
(distance) (direction) (nearest town)

WELL PURPOSE: Home
(home, irrigation, municipal, industrial)

- WELL COMPLETION DATA:
- (1) diameter (inches) 2
 - (2) total depth (feet) 40
 - (3) static water level (feet) 6 ^{below} _{above} top of ground.
 - (4) casing PVC 35
(material) (depth)
 - (size) If telescope see back.
 - (5) screen 5 35
(length) (depth to top)
 - (size) 2 (material) PVC
 - (6) pump 1/2 12
(HP) (yield gpm)
 - (type power) elect
 - (7) electric log (yes or no)

(organization running log)

(8) how well bottom plugged sand SHARK

DRILLERS REMARKS: very good


DEPT. OF NATURAL RESOURCES
BUREAU OF LAND & WATER RESOURCES

JAN 15 1980

RECEIVED

If well telescopes please sketch and show depths.

GROUND LEVEL

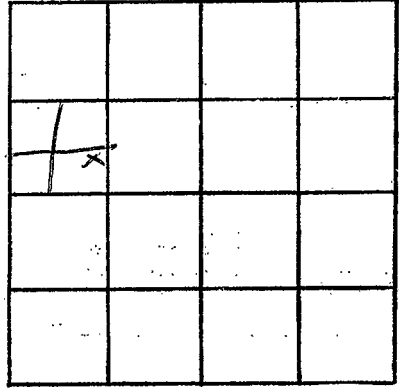

SECTION 20

Please indicate well location X.

ADDITIONAL INFORMATION

If more than one screen, show locations of each on sketch.