

MARION
O 2005
10-30-79

MISSISSIPPI
BOARD OF WATER COMMISSIONERS
416 North State Street
Jackson, Mississippi 39201

WATER WELL DRILLERS LOG

TOM GRIFFITH

PLUMBING & WELL SERVICE, INC.

Marion
county well located

10-30-79
date well completed

LANDOWNER:
V. Christopher
Hub-
(mailing address)

description of formations encountered	from to	
Topsoil	0	1
Chalk	1	15
Sand	15	30

WELL LOCATION:
sec. 13 T. 2 N. R. 12 E.
9 miles W of Hub
(distance) (direction) (nearest town)

WELL PURPOSE: Home
(home, irrigation, municipal, industrial)

- WELL COMPLETION DATA:
- (1) diameter (inches) 2"
 - (2) total depth (feet) 30'
 - (3) static water level (feet) 15' below top of ground.
 - (4) casing Plastic, 20' (material) (depth)
2" (size) if telescope see back.
 - (5) screen 10', 20' (length) (depth to top)
2", Plastic (size) (material)
 - (6) pump 1 (HP) (yield gpm)
Elect. (type power)
 - (7) electric log NO (yes or no)
NO NO (organization running log)
 - (8) how well bottom plugged B.W.V.

DRILLERS REMARKS:


DEPT. OF NATURAL RESOURCES
BUREAU OF LAND & WATER RESOURCES

JAN 7 1980

RECEIVED

If well telescopes please sketch and show depths.

GROUND LEVEL

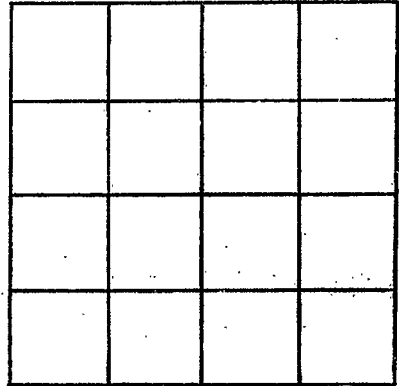

SECTION _____

Please indicate well location X.

ADDITIONAL INFORMATION

If more than one screen, show locations of each on sketch.