

MARION

MISSISSIPPI  
BOARD OF WATER COMMISSIONERS  
416 North State Street  
Jackson, Mississippi 39201

WATER WELL DRILLERS LOG

2006  
4-1-78

4/1 1978 Hollinger Well S. Marion  
date well completed firm name county well located

LANDOWNER: Monna Pittman  
Rt 2  
Foxworth, Ms.  
(mailing address)

description of formations encountered	from	to
<u>sand chn/R</u>	<u>0</u>	<u>15</u>
<u>sand, gravel</u>	<u>15</u>	<u>40</u>

WELL LOCATION:  
sec. 7 T 2 N R 14 E  
6 miles S of Foxworth  
(distance) (direction) (nearest town)

WELL PURPOSE: Home  
(home, irrigation, municipal, industrial)

- WELL COMPLETION DATA:
- (1) diameter (inches) 2"
  - (2) total depth (feet) 40
  - (3) static water level (feet) 15 below above top of ground.
  - (4) casing PVC, 40,  
(material) (depth)  
(size) if telescope see back.
  - (5) screen 5, 35  
(length) (depth to top)  
2", PVC  
(size) (material)
  - (6) pump 1/2, 10  
(HP) (yield gpm)  
elect  
(type power)
  - (7) electric log \_\_\_\_\_  
(yes or no)

(organization running log)  
(8) how well bottom plugged sand  
SHARIC


DRILLERS REMARKS: good well

RECEIVED  
MAY 3 - 1978

MISS. BD. OF WATER COMM

If well telescopes please sketch and show depths.

GROUND LEVEL

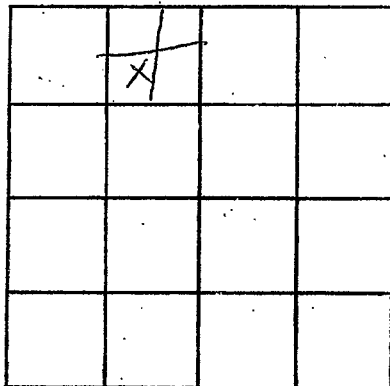

SECTION 7

Please indicate well location X.

ADDITIONAL INFORMATION

Lined area for additional information.

If more than one screen, show locations of each on sketch.