

MISSISSIPPI DEPARTMENT OF NATURAL RESOURCES

Bureau of Land and Water Resources

Southport Mall

P.O. Box 10631

Jackson, Mississippi 39209

WATER WELL DRILLERS LOG

Monon  
0 2009

8-30 1983 Hollinger Spencer  
date well completed firm name county well located

LANDOWNER: <u>Alva Newson</u>	description of formations encountered	from	to
<u>Spring Cottage</u> <u>Columbia, MS</u> (mailing address)	<u>SAND, gravel,</u> <u>clay,</u> <u>part gravel,</u>	<u>10</u>	<u>20</u>
WELL LOCATION: sec. <u>31</u> T. <u>20</u> N. R. <u>14</u> E S W <u>5</u> miles <u>S</u> of <u>Spring Cottage</u> (distance) (direction) (nearest town)		<u>20</u>	<u>40</u>
		<u>40</u>	<u>63</u>
WELL PURPOSE: (home, irrigation, municipal, industrial)			
WELL COMPLETION DATA:			
(1) diameter (inches) <u>2"</u>			
(2) total depth (feet) <u>63</u>			
(3) static water level (feet) <u>10</u> <u>below</u> top of ground. above			
(4) casing <u>PVC</u> , <u>53</u> (material) (depth)			
_____ If telescope see back. (size)			
(5) screen <u>10</u> , <u>53</u> (length) (depth to top)			
(6) pump <u>2"</u> , <u>PVC</u> (size) (material)			
(6) pump <u>1/2</u> , <u>6</u> (HP) (yield gpm)			
(7) electric log <u>elect</u> (type power)			
(7) electric log _____ (yes or no)			
_____ (organization running log)			
(8) how well bottom plugged <u>SAND</u> <u>SHARK</u>			
DRILLERS REMARKS: <u>log d well</u>			


DEPT. OF NATURAL RESOURCES  
BUREAU OF LAND & WATER RESOURCES

SEP 27 1983

RECEIVED

If well telescopes please sketch and show depths.

GROUND LEVEL

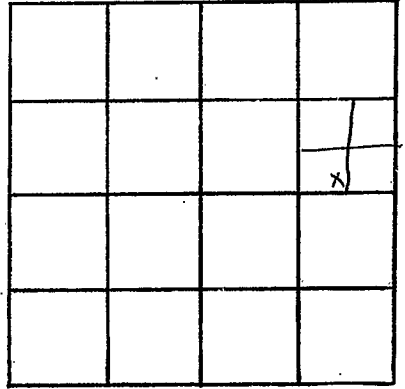

SECTION 31

Please indicate well location X.

ADDITIONAL INFORMATION

If more than one screen,  
show locations of each on sketch.