

MISSISSIPPI DEPARTMENT OF NATURAL RESOURCES

Bureau of Land and Water Resources

Southport Mall

P.O. Box 10631

Jackson, Mississippi 39209

WATER WELL DRILLERS LOG

Manoir
0
2010

10-19 1983 Hollinger Manoir
 date well completed firm name county well located

LANDOWNER: Albroch Co. Inc.
P.O. Box 1155
Chalmette La 70044
 (mailing address)

description of formations encountered	from	to
Red c/ly	0	20
c/ly	20	30
sand	30	50
c/ly	50	55
water sand	55	72

WELL LOCATION:
 sec. 6 T. 20 N. R. 14 E.
5 miles N of SPRING Cottage
 (distance) (direction) (nearest town)

WELL PURPOSE:
 (home, irrigation, municipal, industrial)

WELL COMPLETION DATA:


- (1) diameter (inches) 4
- (2) total depth (feet) 72
- (3) static water level (feet) 21 below above top of ground.
- (4) casing PVC 72
 (material) (depth)
 (size) if telescope see back.
- (5) screen 10 62
 (length) (depth to top)
4 PVC
 (size) (material)
- (6) pump 1/2 12
 (HP) (yield gpm)
elect
 (type power)
- (7) electric log (yes or no)
 (organization running log)
- (8) how well bottom plugged SAND
SHALE

DRILLERS REMARKS: good well

DEPT. OF NATURAL RESOURCES
 BUREAU OF LAND & WATER RESOURCES
 RECEIVED
 NOV 21 1983

If well telescopes please sketch and show depths.

GROUND LEVEL

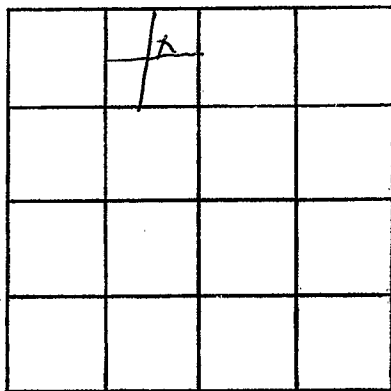

SECTION 6

Please indicate well location X.

ADDITIONAL INFORMATION

If more than one screen,
show locations of each on sketch.