

MISSISSIPPI DEPARTMENT OF NATURAL RESOURCES
 Bureau of Land and Water Resources
 Southport Mall
 P.O. Box 10631
 Jackson, Mississippi 39209
WATER WELL DRILLERS LOG

Marion
0
2011

10-18 1983 Hollinger Marion
 date well completed firm name county well located

LANDOWNER: Al Bluebecker
Spring Cottage, Mo
 (mailing address)

description of formations encountered	from	to
<u>gravel, sand, clay</u>	<u>0</u>	<u>30</u>
<u>clay</u>	<u>30</u>	<u>40</u>
<u>permeable</u>	<u>40</u>	<u>63</u>

WELL LOCATION:
 sec. 6 T. 20 N. R. 14 E.
5 miles N of SPRINGS
 (distance) (direction) (nearest town)

WELL PURPOSE:
 home, irrigation, municipal, industrial

- WELL COMPLETION DATA:
- (1) diameter (inches) 4"
 - (2) total depth (feet) 63
 - (3) static water level (feet) 10 below above top of ground.
 - (4) casing pvc (material), _____ (depth), _____ (size) if telescope see back.
 - (5) screen 10 _____ 53 (length) (depth to top)
4 _____ pvc (size) (material)
 - (6) pump 1/2 _____ 12 (HP) (yield gpm)
elect (type power)
 - (7) electric log _____ (yes or no)
 _____ (organization running log)

(8) how well bottom plugged sand
shrink

DRILLERS REMARKS: Very good well


DEPT. OF NATURAL RESOURCES
 BUREAU OF LAND & WATER RESOURCES

OCT 20 1983

RECEIVED

If well telescopes please sketch and show depths.

GROUND LEVEL

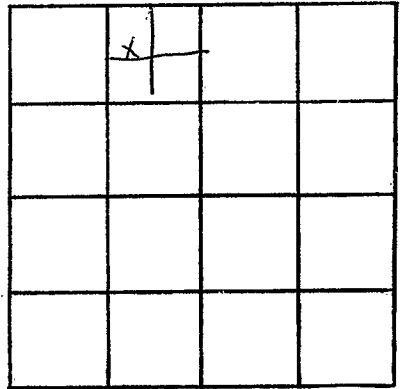

SECTION _____

Please indicate well location X.

ADDITIONAL INFORMATION

If more than one screen,
show locations of each on sketch.