

**MISSISSIPPI
BOARD OF WATER COMMISSIONERS**
416 North State Street
Jackson, Mississippi 39201

WATERWELL DRILLERS LOG
PLUMBING & WELL SERVICE, INC.
320 MAYSON AVE.
COLUMBIA, MS 39429

Marion
0 2012

11/16/83
date well completed

Marion
county well located

LANDOWNER: Ruff A. Anthony
R.1
Columbia, MS.
(mailing address)

description of formations encountered	from	to
<u>Clay</u>	<u>1'</u>	<u>15'</u>
<u>Red Gravel</u>	<u>15'</u>	<u>85'</u>

WELL LOCATION:
sec. 25 T 20 N R 18 E
S W
10 miles S of Columbia
(distance) (direction) (nearest town)

WELL PURPOSE: Home
(home, irrigation, municipal, industrial)

- WELL COMPLETION DATA:
- (1) diameter (inches) 2"
 - (2) total depth (feet) 85'
 - (3) static water level (feet) 20 below top of ground.
 - (4) casing PVC 75'
(material) (depth)
 - N/A if telescope see back.
(size)
 - (5) screen 10' 75'
(length) (depth to top)
 - 2" PVC
(size) (material)
 - (6) pump 1/2 HP 10
(HP) (yield gpm)
 - elec.
(type power)
 - (7) electric log N/A
(yes or no)
 - N/A
(organization running log)
 - (8) how well bottom plugged B.W.V.

DRILLERS REMARKS:


DEPT. OF NATURAL RESOURCES
BUREAU OF LAND & WATER RESOURCES

FEB 16 1984

RECEIVED

If well telescopes please
sketch and show depths.

GROUND LEVEL

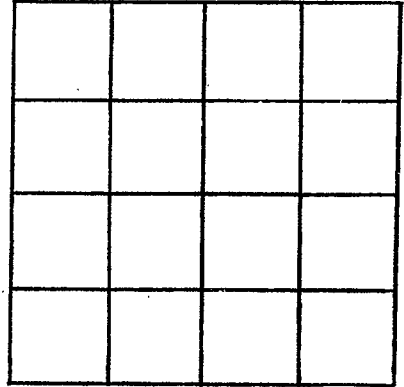

SECTION _____

Please indicate well location X.

ADDITIONAL INFORMATION

If more than one screen,
show locations of each on sketch.