

MISSISSIPPI  
 BOARD OF WATER COMMISSIONERS  
 416 North State Street  
 Jackson, Mississippi 39201

Marion  
0  
2013  
12/29/83 19

WATER WELL DRILLERS LOG

TOM GRIFFITH  
 PLUMBING & WELL SERVICE, INC.

328 WILSON AVE.  
 COLUMBIA, MS 39429

Marion  
 county well located

LANDOWNER: Donald Pierce  
919 High School Ave.  
Columbia, MS  
 (mailing address)

description of formations encountered	from	to
	<u>Chalk</u>	<u>1'</u>
<u>Gravel</u>	<u>5'</u>	<u>50'</u>

WELL LOCATION:  
 sec. 29 T 20 N R 14 E  
10 miles S of Columbia  
 (distance) (direction) (nearest town)

WELL PURPOSE: Home  
 (home, irrigation, municipal, industrial)

WELL COMPLETION DATA:

- (1) diameter (inches) 4"
- (2) total depth (feet) 50
- (3) static water level (feet) 5' below top of ground.
- (4) casing PVC 40  
 (material) (depth)
- N/A if telescope see back.  
 (size)
- (5) screen 10 40  
 (length) (depth to top)  
4" PVC  
 (size) (material)
- (6) pump 1/2 10  
 (HP) (yield gpm)  
Electric  
 (type power)
- (7) electric log N/A  
 (yes or no)  
N/A  
 (organization running log)
- (8) how well bottom plugged B.W.V.

DRILLERS REMARKS:


DEPT. OF NATURAL RESOURCES  
 BUREAU OF LAND & WATER RESOURCES

FEB 16 1984

RECEIVED

If well telescopes please  
sketch and show depths.

GROUND LEVEL

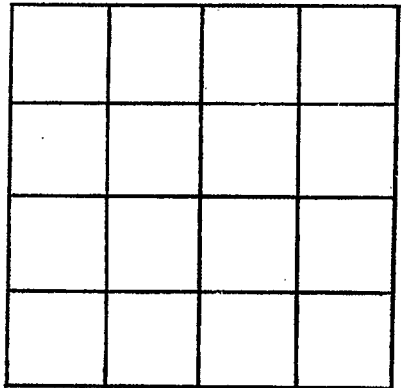

SECTION \_\_\_\_\_

Please indicate well location X.

ADDITIONAL INFORMATION

If more than one screen,  
show locations of each on sketch.