

MISSISSIPPI DEPARTMENT OF NATURAL RESOURCES

Bureau of Land and Water Resources

Southport Mall

P.O. Box 10631

Jackson, Mississippi 39209

WATER WELL DRILLERS LOG

TOM GRIFFITH

PLUMBING & WELL SERVICE, INC.

Marion

Marion
2014

4-11 19 84
date well completed

firm name 320 MAYSON AVE.

county well located

LANDOWNER: Parker Ball

description of formations encountered	from	to
	Clay-Gravel	1' 10"
Clay	10'	20'
Gravel	20'	40'
Red Gravel	40'	90'

R. 2 Box 97A
Columbia, MS 39429
(mailing address)

WELL LOCATION:

sec. 15 T-2N R-14E
2 1/2 miles SE of Cheraw
(distance) (direction) (nearest town)

WELL PURPOSE:

Home (home, irrigation, municipal, industrial)

WELL COMPLETION DATA:

- (1) diameter (inches) 4"
- (2) total depth (feet) 90'
- (3) static water level (feet) 10' below top of ground.
- (4) casing PVC, 90' (material), (depth)
N/A (size) if telescope see back.
- (5) screen 10' length, 80' depth to top
4" (size), PVC (material)
- (6) pump 1/2 Sub. 20' (HP), (yield gpm)
Elec. (type power)
- (7) electric log N/A (yes or no)
N/A (organization running log)
- (8) how well bottom plugged BWV

DRILLERS REMARKS:


DEPT. OF NATURAL RESOURCES
BUREAU OF LAND & WATER RESOURCES

MAY - 2 1984

RECEIVED

If well telescopes please sketch and show depths.

GROUND LEVEL

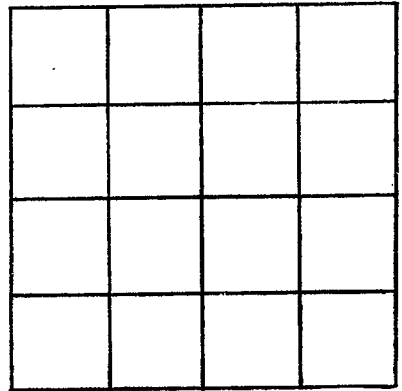

SECTION _____

Please indicate well location X.

ADDITIONAL INFORMATION

If more than one screen,
show locations of each on sketch.