

MISSISSIPPI DEPARTMENT OF NATURAL RESOURCES

Bureau of Land and Water Resources

Southport Mall

P.O. Box 10631

Jackson, Mississippi 39209

WATER WELL DRILLERS LOG

Marion
Φ 2015

10-28-86

19

TOAN GRIFITH WATER WELL

firm name

MARION

county well located

LANDOWNER: Billy Joe Ealey

description of formations encountered

from

to

Foxworth, Ms
 (mailing address)

RED SAND
P- Gravel

1' 60'
60' 140'

WELL LOCATION:

sec. 2 T. 2 (N) S R. 18 (E) (W)

1.0 miles South of Columbia
 (distance) (direction) (nearest town)

WELL PURPOSE: HOME
 (home, irrigation, municipal, industrial)

WELL COMPLETION DATA:

(1) diameter (inches) 6"
 (2) total depth (feet) 140'
 (3) static water level (feet) 75' below above
 top of ground.

(4) casing PVC, 130'
 (material) (depth)
4"
 (size) if telescope see back.

(5) screen 10', 130'
 (length) (depth to top)
4", PVC
 (size) (material)

(6) pump 1, 15
 (HP) (yield gpm)
230 V
 (type power)

(7) electric log No
 (yes or no)
NA
 (organization running log)

(8) how well bottom plugged
BWV

DRILLERS REMARKS:


RECEIVED

NOV 7 1986

Department of Natural Resources
 Bureau of Land & Water Resources

If well telescopes please sketch and show depths.

GROUND LEVEL

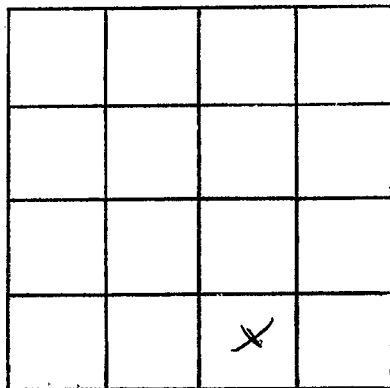

SECTION _____

SECTION _____

Please indicate well location X.

ADDITIONAL INFORMATION

Multiple horizontal lines for additional information.

If more than one screen, show locations of each on sketch.