

MISSISSIPPI DEPARTMENT OF NATURAL RESOURCES
Bureau of Land and Water Resources
Southport Mall
P.O. Box 10631
Jackson, Mississippi 39209
WATER WELL DRILLERS LOG

<u>Marion</u>
<u>Φ 206</u>

4-3-87 19 Louis Batson Marion
date well completed firm name county well located

LANDOWNER: <u>Nelson Hicks</u>	description of formations encountered	from	to
<u>Rt. 1</u>	<u>Chalk</u>	<u>1</u>	<u>8</u>
<u>Columbia, MS. 39429</u> (mailing address)	<u>Sand, gravel</u>	<u>9</u>	<u>105</u>

WELL LOCATION:
sec. 26 T. 2 N. R. 18 E.
13 miles South of Columbia
(distance) (direction) (nearest town)

WELL PURPOSE:
(home, irrigation, municipal, industrial)

- WELL COMPLETION DATA:**
- (1) diameter (inches) 4"
 - (2) total depth (feet) 105
 - (3) static water level (feet) 100 below top of ground.
 - (4) casing PVC, 105,
(material) (depth)
4 if telescope see back.
(size)
 - (5) screen 20, 85
(length) (depth to top)
4, PVC
(size) (material)
 - (6) pump 1 1/2,
(HP) (yield gpm)
220
(type power)
 - (7) electric log _____
(yes or no)

(organization running log)
 - (8) how well bottom plugged _____

RECEIVED

APR 29 1987

Department of Natural Resources
Bureau of Land & Water Resources

DRILLERS REMARKS:


If well telescopes please sketch and show depths.

GROUND LEVEL

105ft

20 ft.
Screen

If more than one screen,
show locations of each on sketch.

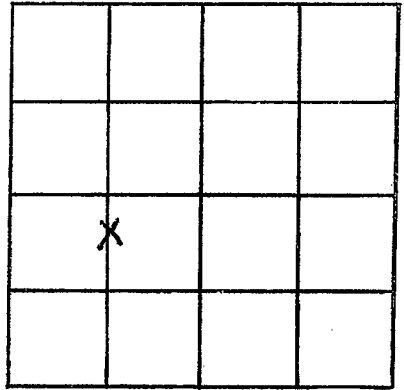

SECTION 26

Please indicate well location X.

ADDITIONAL INFORMATION

Lined area for additional information.