

MISSISSIPPI DEPARTMENT OF NATURAL RESOURCES

Bureau of Land and Water Resources

Southport Mall

P.O. Box 10631

Jackson, Mississippi 39209

WATER WELL DRILLERS LOG

Marion  
CS  
2019

3-21 1986  
 date well completed

Fitzgerald well Co Marion  
 firm name

county well located

LANDOWNER:	description of formations encountered	from	to
<u>Richard Price</u>	<u>Red sand</u>	<u>0</u>	<u>20</u>
<u>P.B. Columbia Ms.</u> (mailing address)	<u>Coarse sand &amp; gravel</u>	<u>10</u>	<u>40</u>
<b>WELL LOCATION:</b>			
sec. <u>20</u> T- <u>2</u> N R- <u>14</u> E S W			
<u>3</u> miles <u>S</u> of <u>CHERAW</u> (distance) (direction) (nearest town)			
<b>WELL PURPOSE:</b> <u>Home</u> (home, irrigation, municipal, industrial)			
<b>WELL COMPLETION DATA:</b>			
(1) diameter (inches) <u>4</u>			
(2) total depth (feet) <u>40</u>			
(3) static water level (feet) <u>10</u> below above top of ground.			
(4) casing <u>PVC</u> , <u>30</u> , (material) (depth) <u>4</u> (size) if telescope see back.			
(5) screen <u>10</u> , <u>30</u> (length) (depth to top) <u>4</u> , <u>PVC</u> (size) (material)			
(6) pump <u>1/2</u> , <u>10</u> (HP) (yield gpm) <u>Ele</u> (type power)			
(7) electric log <u>No</u> (yes or no)			
(organization running log)			
(8) how well bottom plugged <u>Sand block</u>			


RECEIVED  
 RECEIVED  
 MAY 5 1986

DRILLERS REMARKS:

Department of Natural Resources  
 Bureau of Land & Water Resources

If well telescopes please sketch and show depths.

GROUND LEVEL

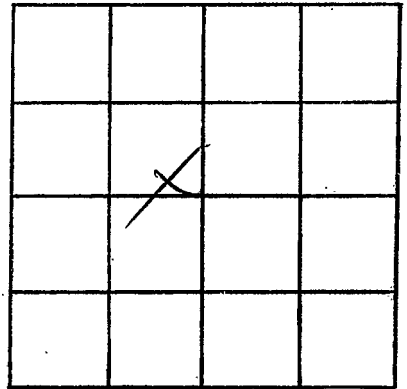

SECTION 20

Please indicate well location X.

ADDITIONAL INFORMATION

If more than one screen,  
show locations of each on sketch.