

MISSISSIPPI DEPARTMENT OF NATURAL RESOURCES

Bureau of Land and Water Resources

Southport Mall

P.O. Box 10631

Jackson, Mississippi 39209

WATER WELL DRILLERS LOG

Mason
2021

4/2/87 1987 Stop and Well Mason
 date well completed well name county well located

LANDOWNER:
James A. Smith
 (mailing address)

description of formations encountered	from	to
<u>Top Soil</u>	<u>0</u>	<u>1</u>
<u>sandy clay</u>	<u>1</u>	<u>40</u>
<u>sand</u>	<u>40</u>	<u>90</u>
<u>Shale</u>	<u>90</u>	<u>160</u>
<u>fine sand</u>	<u>160</u>	<u>210</u>
<u>Shale</u>	<u>210</u>	<u>240</u>
<u>course sand</u>	<u>240</u>	<u>290</u>

WELL LOCATION:
 sec 5 T 2 N R 18 E
7 miles South of Columbus
 (distance) (direction) (nearest town)

WELL PURPOSE:
Home
 (home, irrigation, municipal, industrial)

WELL COMPLETION DATA:

(1) diameter (inches) 4"

(2) total depth (feet) 290 ft.

(3) static water level (feet) 40 below above top of ground.

(4) casing plastic, 270,
 (material) (depth)
4"
 (size) if telescope see back.

(5) screen 20, 270
 (length) (depth to top)
4", plastic
 (size) (material)

(6) pump 2hp, 40
 (HP) (yield gpm)
Electric
 (type power)

(7) electric log _____
 (yes or no)

 (organization running log)

(8) how well bottom plugged BWD

DRILLERS REMARKS: [Signature]


RECEIVED

JUN 16 1987

Department of Natural Resources
 Bureau of Land & Water Resources

If well telescopes please sketch and show depths.

GROUND LEVEL

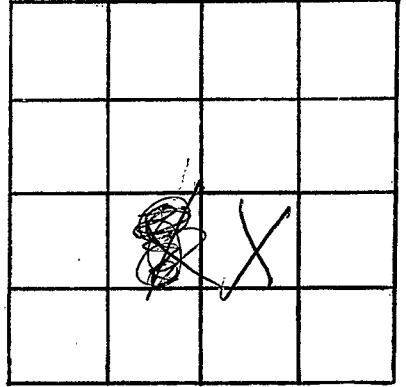

SECTION _____

Please indicate well location X.

ADDITIONAL INFORMATION

If more than one screen,
show locations of each on sketch.