

MISSISSIPPI DEPARTMENT OF NATURAL RESOURCES
Bureau of Land and Water Resources
 Southport Mall
 P.O. Box 10631
 Jackson, Mississippi 39209
WATER WELL DRILLERS LOG

Mason
 2022

9-21 1987 *Hollinger* *Mason*
 date well completed firm name county well located

LANDOWNER: *John Pittman*
RT 1
Sandy Hook, MS.
 (mailing address)

description of formations encountered	from	to
<i>Sand, gravel</i>	<i>0</i>	<i>20</i>
<i>Dark sand, pea gravel</i>	<i>20</i>	<i>40</i>
<i>Sandy pea gravel</i>	<i>40</i>	<i>70</i>

WELL LOCATION:
 sec ~~32~~ T 2 (N) S R 14 (E) W
2 miles N of Sandy Hook
 (distance) (direction) (nearest town)

WELL PURPOSE:
 (home, irrigation, municipal, industrial)

WELL COMPLETION DATA:

- (1) diameter (inches) 2"
- (2) total depth (feet) 70
- (3) static water level (feet) 10 ^{below} _{above} top of ground.
- (4) casing PVC, 60,
 (material) (depth)
 (size) if telescope see back.
- (5) screen 10 60
 (length) (depth to top)
2, PVC
 (size) (material)
- (6) pump None 8
 (HP) (yield gpm)
elect
 (type power)
- (7) electric log _____
 (yes or no)
 (organization running log)

(8) how well bottom plugged Sand
Shark

DRILLERS REMARKS: Very Good
well


RECEIVED

DEC 11 1987

Department of Natural Resources
 Bureau of Land & Water Resources

If well telescopes please sketch and show depths.

GROUND LEVEL

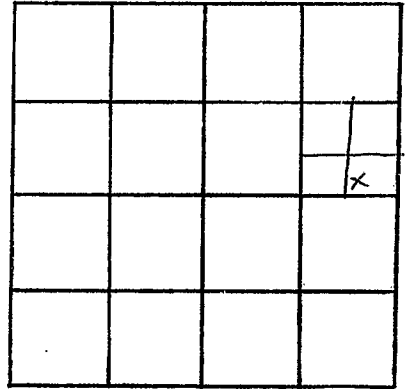

SECTION 32

Please indicate well location X.

ADDITIONAL INFORMATION

If more than one screen, show locations of each on sketch.