




If well telescopes please sketch and show depths.

GROUND LEVEL

100 ft

7 ft  
Screen  
back  
wash  
valve

If more than one screen,  
show locations of each on sketch.

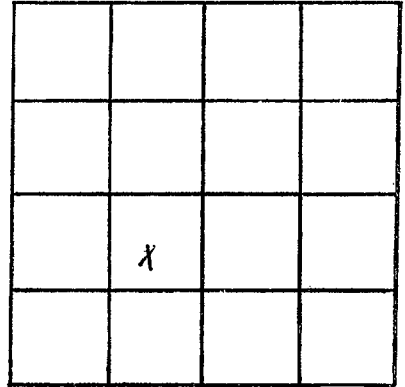

SECTION 25

Please indicate well location X.

ADDITIONAL INFORMATION

Multiple horizontal lines for additional information.