

Marion
\$ 2024

MISSISSIPPI DEPARTMENT OF NATURAL RESOURCES
Bureau of Land and Water Resources
Southport Mall
P.O. Box 10631
Jackson, Mississippi 39209
WATER WELL DRILLERS LOG

1-18 1989 Hollinger Marion
date well completed firm name county well located

LANDOWNER: Arnel Cochran description of formations encountered from to
RT 1 Sandy, Gravel 0 90
Spring Cottage 875
(mailing address)

WELL LOCATION:
sec. 35 T. 20 N. R. 18 E. S. 10 W.
10 miles S of Columbia
(distance) (direction) (nearest town)

WELL PURPOSE:
(home, irrigation, municipal, industrial)

WELL COMPLETION DATA:


- (1) diameter (inches) 4"
- (2) total depth (feet) 90
- (3) static water level (feet) 10 below above top of ground.
- (4) casing pvc (material), (depth) _____ if telescope see back. (size)
- (5) screen 10 80 (length) (depth to top)
4 (size) pvc (material)
- (6) pump 1/2 9 (HP) (yield gpm)
elect. (type power)
- (7) electric log (yes or no) _____
(organization running log) _____
- (8) how well bottom plugged sand shale

DRILLERS REMARKS: good well

MISSISSIPPI DEPARTMENT OF NATURAL RESOURCES
BUREAU OF LAND AND WATER RESOURCES
MAR 22 1989
RECEIVED

If well telescopes please sketch and show depths.

GROUND LEVEL

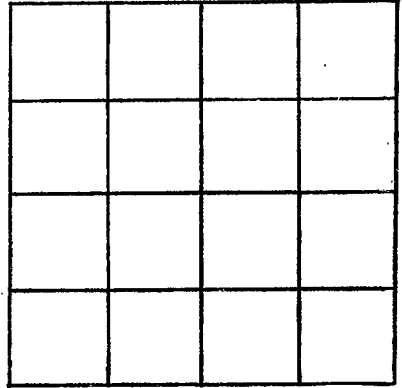

SECTION _____

Please indicate well location X:

ADDITIONAL INFORMATION

If more than one screen,
show locations of each on sketch.