

MISSISSIPPI DEPARTMENT OF NATURAL RESOURCES

Bureau of Land and Water Resources

Southport Mall

P.O. Box 10631

Jackson, Mississippi 39209

WATER WELL DRILLERS LOG

Griner Drilling Service, Inc.

Marion

Marion
2025

NOT COPIED
2/20/85

12-18-90
date well completed

Griner Drilling Service, Inc.
firm name

Marion
county well located

LANDOWNER:

Exxon Company, U.S.A.
P.O. Box 60006
New Orleans, La. 70160
(mailing address)

description of formations encountered

from

to

sand, pea gravel 0 150

WELL LOCATION: 1500'S + 1500'E

sec. 19 T 20 N R 14 E of
Hub Field

(distance) miles (direction) (nearest town)

No. 2 Water

WELL PURPOSE: oilfield rig
(home, irrigation, municipal, industrial)

Well

WELL COMPLETION DATA:

(1) diameter (inches) 4"

(2) total depth (feet) 150'

(3) static water level (feet) 4' below top of ground.

(4) casing steel 150' (material), (depth)

4" (size) if telescope see back.

(5) screen 20' 130' to 150' (length) (depth to top)

4" stainless (size) (material)

(6) pump 5 440 volt (HP) (yield gpm)

3 phase 100 GPM (type power)

(7) electric log (yes or no)

(organization running log)

(8) how well bottom plugged 4"

backwash valve

DRILLERS REMARKS:

No. 1 Helen K. Ball


RECEIVED

JAN 16 1991

Dept. of Environmental Quality
Bureau of Land & Water Resources

If well telescopes please sketch and show depths.

GROUND LEVEL

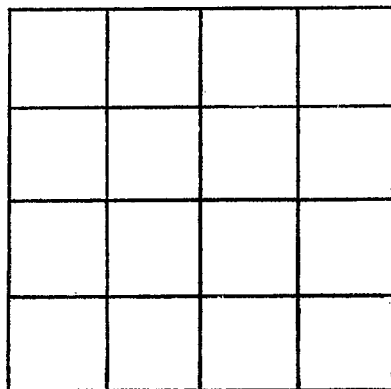

SECTION _____

Please indicate well location X.

ADDITIONAL INFORMATION

If more than one screen,
show locations of each on sketch.