

0-2042

MISSISSIPPI DEPARTMENT OF ENVIRONMENTAL QUALITY

Office of Land and Water Resources

COUNTY WELL LOCATED <i>Marion</i>	
WELL NUMBER <i>E&H Price</i>	CODED
<i>26-4 #1</i>	
DATE WELL COMPLETED <i>6-2-00</i>	

PERMIT NUMBER <i>0-60</i>
NAME OF DRILLING FIRM <i>Rayborn Drilling</i>

P. O. Box 10631
Jackson, MS 39289-0631
WATER WELL DRILLERS LOG

NAME & MAILING ADDRESS OF LANDOWNER <i>Energy Drilling</i>			
<i>P.O. Box 905</i>			
<i>Natchez, MS 39120</i>			
WELL LOCATION:	SEC	TOWNSHIP	RANGE
	<i>23</i>	<i>2</i>	<i>18</i>
DISTANCE	DIRECTION	NEAREST TOWN	
	Miles	of	
OTHER LANDMARK			
WELL PURPOSE: Home, Irrigation, Municipal, Industrial, Fish Pond, etc. <i>oilfield</i>			

PUMP DATA		
PUMP TYPE (Circle One): Submersible, Turbine, Jet, Flowing Well, Other (Describe) _____		
POWER TYPE (Circle One): Electric, Tractor, Diesel, Gasoline, Butane, Other (Describe) _____ H/P _____		
Pump Capacity (GPM)	No. of Stages	Setting Depth
		FT.
PUMP TEST		
Well yielded _____ GPM with a drawdown of _____ ft. after _____ hours of pumping		

WELL DATA		
Well Depth <i>76</i>	Casing Diameter (In.) <i>4</i>	Casing Length (Ft.) <i>56</i>
Type of Casing <i>PVC</i>	Hole Depth <i>76</i>	Depth to Static Water Level <i>12</i>

LOG DATA	
TYPE OF LOG RUN (Circle One): No Log Run, Electric, Gamma Ray, Density, Sonic, Neutron, Other (Describe) _____	
Name of Organization Running Log	

TYPE OF COMPLETION: (Circle One or More):
Gravel Packed, Underreamed, Telescoped,
Natural Development, Open Hole, Other
(Describe) _____

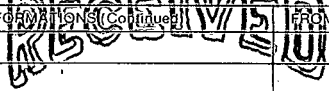
GEOLOGIC DATA (Office Use Only)			
Surface Elev.	Geologic Unit	Unit Thickness	Depth to Top
Subs. SWL	Date	Analysis	Aquifer Test

WELL GROUTED TO A DEPTH OF *16* FEET
Type Grout (circle one): Cement, Bentonite, or Mix

SCREEN DATA		
Diameter - Inches <i>4</i>	Length - Feet <i>20</i>	Slot Size - Inches <i>.020</i>
Screen Type <i>PVC</i>	Depth to Bottom - Feet <i>76</i>	

Driller's Remarks	
Top of Lap Pipe or Reduction in Casing	
FEET	IF TELESCOPED OR MORE THAN ONE SCREEN: USE BACK PAGE

DESCRIPTION OF FORMATIONS ENCOUNTERED	FROM	TO
<i>Topsoil</i>	<i>0</i>	<i>2</i>
<i>Chalk</i>	<i>2</i>	<i>17</i>
<i>Gravel</i>	<i>17</i>	<i>76</i>

FORMATIONS (Continued)		FROM	TO
			
<i>JUN 08 2000</i>			
Dept. of Environmental Quality Office of Land & Water Resources			
IF MORE SPACE IS NEEDED, USE BACK			

