

CODED

MISSISSIPPI
BOARD OF WATER COMMISSIONERS
416 North State Street
Jackson, Mississippi 39201

WATER WELL DRILLERS LOG

Marion

P 50

1-15-70

1/15

date well completed

19 70 Dean Limer

firm name

Marion

county well located

LANDOWNER:

description of formations encountered

from

to

Mr. Owens paper

Top soil

0 1'

Route 5 Columbia, Miss.
(mailing address)

red clay

1-30

WELL LOCATION:

red sand

30-40

sec 23 T 3 N S R 17 E W

Chalk

40-60

miles of Columbia
(distance) (direction) (nearest town)

fine white sand

60-75

WELL PURPOSE: Home Well
(home, irrigation, municipal, industrial)

Coarse water sand

75-95

WELL COMPLETION DATA:

(1) diameter (inches) 4"

(2) total depth (feet) 95'

(3) static water level (feet) 65' below top of ground.

(4) casing Plastic, 85'
(material) (depth)

if telescope see back.
(size)

(5) screen 10' 85'
(length) (depth to top)

4"x10", Plastic
(size) (material)

(6) pump 1 1/2 HP
(HP) (yield gpm)

J. B. M. Sub. Pump
(type power)

(7) electric log NO
(yes or no)

(organization running log)

(8) how well bottom plugged


DRILLERS REMARKS:

MAR 18 1970

MISS. BD. OF
WATER COMM.

If well telescopes please sketch and show depths.

GROUND LEVEL

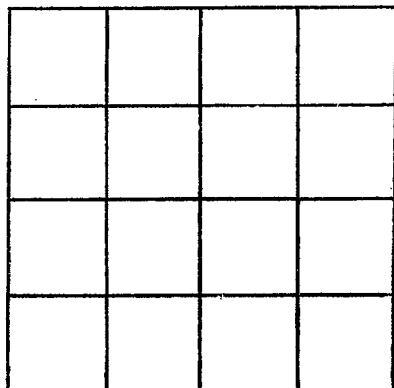

SECTION _____

Please indicate well location X.

ADDITIONAL INFORMATION

If more than one screen, show locations of each on sketch.