

MARION
P 51
5-17-71

MISSISSIPPI
BOARD OF WATER COMMISSIONERS
416 North State Street
Jackson, Mississippi 39201

CODED

WATER WELL DRILLERS LOG

5-17-71
date well completed

Deane's Drilling Co.
firm name

Marion
county well located

LANDOWNER:
Shepard Buckley
Route 5 Columbia, Miss.
(mailing address)

description of formations encountered	from	to
<i>top soil</i>	<i>0</i>	<i>1</i>
<i>red clay</i>	<i>1</i>	<i>10'</i>
<i>gravel</i>	<i>10</i>	<i>90'</i>
<i>Chalk</i>	<i>90</i>	<i>120</i>
<i>water sand</i>	<i>120</i>	<i>185</i>

WELL LOCATION:
sec *24* T-*2* N R-*17* E
S W
18 miles (distance) *SW* (direction) of *Columbia* (nearest town)

WELL PURPOSE: *house use*
(home, irrigation, municipal, industrial)

- WELL COMPLETION DATA:
- (1) diameter (inches) *4"*
 - (2) total depth (feet) *185'*
 - (3) static water level (feet) _____ below/above top of ground.
 - (4) casing *plastic 175'*
(material) (depth)
_____ if telescope see back.
(size)
 - (5) screen *10'* *175'*
(length) (depth to top)
4" *plastic*
(size) (material)
 - (6) pump *3/4* (HP) _____ (yield gpm)

(type power)
 - (7) electric log _____ (yes or no)

(organization running log)
 - (8) how well bottom plugged _____

CODED


MAY 19 1971

DRILLERS REMARKS:

MISS. BD. OF
WATER COMMISSIONERS

If well telescopes please sketch and show depths.

GROUND LEVEL

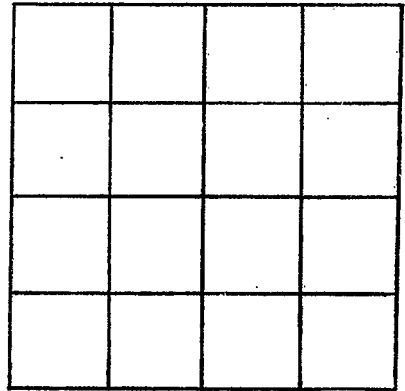

SECTION _____

Please indicate well location X.

ADDITIONAL INFORMATION

If more than one screen, show locations of each on sketch.