

MARION
P 52
12-71

MISSISSIPPI
 BOARD OF WATER COMMISSIONERS
 -416 North State Street
 Jackson, Mississippi 39201

CODED

WATER WELL DRILLERS LOG

DEC 1971 E.B. SHERARD MARION
 date well completed firm name county well located

LANDOWNER:
WILLIE JEFFERSON
RT. 5 - Columbia, Miss.
 (mailing address)

description of formations encountered	from	to
<u>RED SANDY CLAY</u>	<u>0</u>	<u>20</u>
<u>GRAY CLAY</u>	<u>20</u>	<u>60</u>
<u>SAND + PEAL GRAVEL</u>	<u>60</u>	<u>83</u>

WELL LOCATION:
 sec 30 T 2 N R 17 E
10 miles SE of COLUMBIA
 (distance) (direction) (nearest town)

WELL PURPOSE:
 (home) irrigation, municipal, industrial

- WELL COMPLETION DATA:
- (1) diameter (inches) 2"
 - (2) total depth (feet) 83
 - (3) static water level (feet) 45 below top of ground.
 - (4) casing PL. 78
 (material) (depth)
2" if telescope see back.
 (size)
 - (5) screen 5' PL.
 (length) (depth, to top)
2" (size) (material)
 - (6) pump 3/4 8
 (HP) (yield gpm)
E
 (type power)
 - (7) electric log (yes or no)
 - (organization running log)
 - (8) how well bottom plugged BWV


CODED

NOV 28 1972

DRILLERS REMARKS:

If well telescopes please sketch and show depths.

GROUND LEVEL

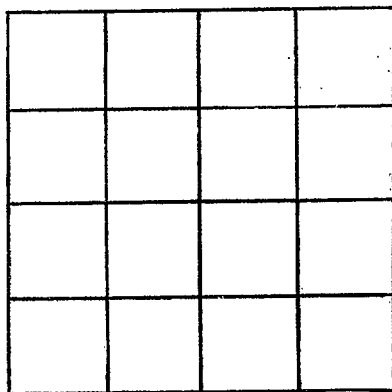

SECTION _____

Please indicate well location X.

ADDITIONAL INFORMATION

If more than one screen, show locations of each on sketch.