

MARION  
P 53  
3-72

MISSISSIPPI  
BOARD OF WATER COMMISSIONERS  
416 North State Street  
Jackson, Mississippi 39201

**CODED**

WATER WELL DRILLERS LOG

March 1972 E.B. Sherrard Marion  
date well completed firm name county well located

LANDOWNER:

Jimmy Sanchez  
Rt. 5 - Columbia  
(mailing address)

description of formations encountered

description of formations encountered	from	to
WATER SANDY CLAY	0	140
SANDY CLAY	140	160
SANDY CLAY	160	240
STRAKES	160	240
BLUE CLAY & GRAY CLAY		
STRAKES	240	300
FINE SAND	300	340
COARSE SAND	340	388

WELL LOCATION:

sec 23 T. 2 N R. 17 E  
S  
12 miles SE Columbia  
(distance) (direction) (nearest town)

WELL PURPOSE:

(home) irrigation, municipal, industrial

WELL COMPLETION DATA:


- diameter (inches) 3"
- total depth (feet) 398
- static water level (feet) 178 <sup>below</sup> <sub>above</sub> top of ground.
- casing pl 388  
(material) (depth)  
3" if telescope see back.  
(size)
- screen 10'  
(length) (depth to top)  
3" pl  
(size) (material)
- pump 1/2 5  
(HP) (yield gpm)  
e  
(type power)
- electric log (yes or no)
- (organization running log)
- how well bottom plugged Bwo

MAR 26 1972


MISS. BD. OF  
WATER COMMISSIONERS

DRILLERS REMARKS:

If well telescopes please sketch and show depths.

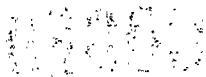

GROUND LEVEL

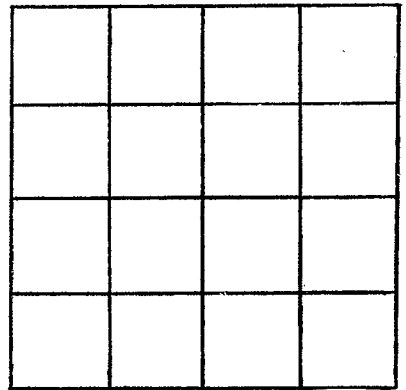

SECTION \_\_\_\_\_

Please indicate well location X.

ADDITIONAL INFORMATION

If more than one screen,  
show locations of each on sketch.