

MARION
P 55
5-4-73

MISSISSIPPI
BOARD OF WATER COMMISSIONERS
416 North State Street
Jackson, Mississippi 39201

CODED

WATER WELL DRILLERS LOG

May 4 1973 Super Water Well Serv. Marion
date well completed firm name county well located

LANDOWNER:
Glen Bryant
Rt # 5, Franksville
(mailing address)

description of formations encountered	from	to
<u>Top Soil</u>	<u>0</u>	<u>2</u>
<u>Clay</u>	<u>2</u>	<u>22</u>
<u>Sand</u>	<u>21</u>	<u>31</u>
<u>Chalk</u>	<u>31</u>	<u>155</u>
<u>Sand & Pea Gravel</u>	<u>155</u>	<u>182</u>

WELL LOCATION:
sec. 16 T 2 N R 17 E
1/2 miles West of Franksville
(distance) (direction) (nearest town)

WELL PURPOSE: Home
(home, irrigation, municipal, industrial)

CODED

- WELL COMPLETION DATA:
- (1) diameter (inches) 2"
 - (2) total depth (feet) 180 ft.
 - (3) static water level (feet) 15 below top of ground.
 - (4) casing Plastic, 168,
(material) (depth)
(size) if telescope see back.
 - (5) screen 10,
(length) (depth to top)
2", Plastic
(size) (material)
 - (6) pump _____ (HP) _____ (yield gpm)
(type power)
 - (7) electric log _____ (yes or no)
(organization running log)
 - (8) how well bottom plugged Foot Valve


DRILLERS REMARKS:

JUN 27 1973

MISSISSIPPI
BOARD OF WATER COMMISSIONERS

If well telescopes please sketch and show depths.

GROUND LEVEL

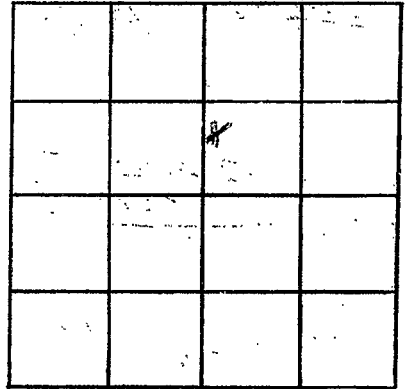

SECTION _____

Please indicate well location X.

ADDITIONAL INFORMATION

If more than one screen,
show locations of each on sketch.