

MARION

~~PEARLS~~

MISSISSIPPI
BOARD OF WATER COMMISSIONERS
416 North State Street
Jackson, Mississippi 39201

RECORDED

PS6
2-22-74

WATER WELL DRILLERS LOG

2-22-74 date well completed
1974 Mc Lebus Water Well Co. firm name
Marion county well located

LANDOWNER: James Lauder
Rt 1 Poplarville, Miss

description of formations encountered	from	to
Top layer of clay	0	45
Fine sand	45	60
Clay	60	140
Sand	140	180

(mailing address)

WELL LOCATION:

sec 5 T 2 N R 17 W
23 miles NE of Crossroad
(distance) (direction) (nearest town)

WELL PURPOSE: Home
(home, irrigation, municipal, industrial)

WELL COMPLETION DATA:

- (1) diameter (inches) 4"
- (2) total depth (feet) 180'
- (3) static water level (feet) 80' below top of ground.
- (4) casing PVC 180' (material) (depth)
- (5) screen 10' 170' (length) (depth to top)
4" PVC (size) (material)
- (6) pump 15 (HP) (yield gpm)
Electric (type power)
- (7) electric log no. (yes or no)

CODED


(organization running log)

(8) how well bottom plugged Barb Wash valve

DRILLERS REMARKS:

If well telescopes please sketch and show depths.

GROUND LEVEL

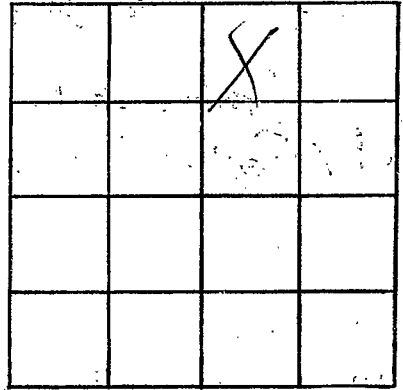

SECTION 36

Please indicate well location X.

ADDITIONAL INFORMATION

If more than one screen, show locations of each on sketch.