

P57  
 marion  
 1/20/75

MISSISSIPPI  
 BOARD OF WATER COMMISSIONERS  
 416 North State Street  
 Jackson, Mississippi 39201

CODED

WATER WELL DRILLERS LOG

1-20 1975 Oriver - GIRD MARION  
 date well completed firm name county well located

LANDOWNER: X  
Quillie Lee Johnson  
Rt. 5, Box 207  
Columbia (mailing address) Miss

description of formations encountered	from	to
<u>top Soil</u>	<u>0</u>	<u>1</u>
<u>Clay</u>	<u>1</u>	<u>32</u>
<u>Sand</u>	<u>32</u>	<u>100</u>

WELL LOCATION:  
 sec. 18 T. 2 N. R. 12E  
8 miles SW of Columbia  
 (distance) (direction) (nearest town)

WELL PURPOSE: Home  
 (home, irrigation, municipal, industrial)

- WELL COMPLETION DATA:
- (1) diameter (inches) 2"
  - (2) total depth (feet) 100
  - (3) static water level (feet) 30 below above top of ground.
  - (4) casing PVC, 90,  
 (material) (depth)  
2" if telescope see back.  
 (size)
  - (5) screen 10', 90  
 (length) (depth to top)  
2", PVC  
 (size) (material)
  - (6) pump 1/2 (HP) (yield gpm)  
elec  
 (type power)
  - (7) electric log NO  
 (yes or no)

(organization running log)  
 (8) how well bottom plugged  
B.W. Valve


DRILLERS REMARKS:

RECORDED

JUN 6 1975

If well telescopes please sketch and show depths.

GROUND LEVEL

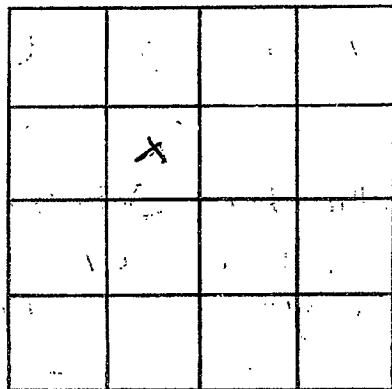

SECTION 18

Please indicate well location X.

ADDITIONAL INFORMATION

If more than one screen, show locations of each on sketch.