

MISSISSIPPI  
BOARD OF WATER COMMISSIONERS  
416 North State Street  
Jackson, Mississippi 39201

CODED

WATER WELL DRILLERS LOG

5-28 1975 Burier-Ginn Marion  
date well completed firm name county well located

LANDOWNER:

R.M.H.D.C.

L. J. Fortenberry  
(mailing address)

WELL LOCATION:

sec. 18 T. 2 N. R. 17 E.  
12 miles SE of Calumet  
(distance) (direction) (nearest town)

WELL PURPOSE: Home  
(home, irrigation, municipal, industrial)

WELL COMPLETION DATA:


- (1) diameter (inches) 2"
- (2) total depth (feet) 100'
- (3) static water level (feet) 70' below above top of ground.
- (4) casing Plastic 90'  
(material) (depth)  
2"  
(size) if telescope see back.
- (5) screen 10' 90'  
(length) (depth to top)  
2" Plastic  
(size) (material)
- (6) pump 1 (HP) (yield gpm)  
Electric  
(type power)
- (7) electric log no  
(yes or no)
- (organization running log)
- (8) how well bottom plugged bw valve

description of formations encountered

from to

top soil	0	1
clay	1	36
clay & gravel	36	58
clay	58	72
sand	72	100


DRILLERS REMARKS:

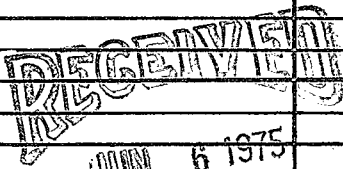

MISS. BD. OF WATER COMM.

If well telescopes please sketch and show depths.

GROUND LEVEL

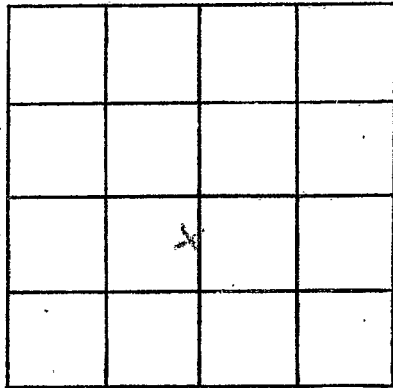

SECTION 18

Please indicate well location X.

ADDITIONAL INFORMATION

If more than one screen, show locations of each on sketch.