

Marion
P-65
11-29-79

MISSISSIPPI
 BOARD OF WATER COMMISSIONERS
 416 North State Street
 Jackson, Mississippi 39201

WATER WELL DRILLERS LOG

11-29-79 19 DM Giffith Marion
 date well completed firm name county well located

LANDOWNER:	description of formations encountered	from	to
<u>Lene Smith</u> <u>Rt. 2 Columbia</u> (mailing address)		<u>TOPSOIL</u> <u>CHALK</u> <u>SAND</u>	<u>0</u>
WELL LOCATION:			
sec. <u>7</u> T <u>2</u> (N) R <u>17</u> E			
<u>2</u> miles <u>N</u> of <u>Pinebar</u>			
(distance) (direction) (nearest town)			
WELL PURPOSE: <u>Home</u>			
(home, irrigation, municipal, industrial)			
WELL COMPLETION DATA:			
(1) diameter (inches) <u>2"</u>			
(2) total depth (feet) <u>210'</u>			
(3) static water level (feet) <u>75'</u> <u>below</u> above top of ground.			
(4) casing <u>Plastic</u> , <u>190'</u>			
(material) (depth)			
<u>2"</u> If telescope see back.			
(size)			
(5) screen <u>20'</u> , <u>190'</u>			
(length) (depth to top)			
<u>2"</u> , <u>Plastic</u>			
(size) (material)			
(6) pump <u>1</u> , <u>45</u>			
(HP) (yield gpm)			
<u>ELect</u>			
(type power)			
(7) electric log <u>NO</u>			
(yes or no)			
<u>NONE</u>			
(organization running log)			
(8) how well bottom plugged <u>B.W.V.</u>			
DRILLERS REMARKS:			


DEPT. OF NATURAL RESOURCES
 BUREAU OF LAND & WATER RESOURCES

JAN 7 1980

RECEIVED

If well telescopes please sketch and show depths.

GROUND LEVEL

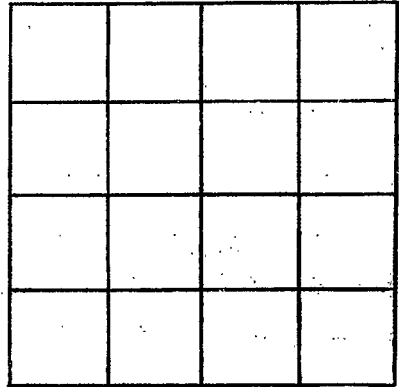

SECTION: _____

Please indicate well location X.

ADDITIONAL INFORMATION

If more than one screen, show locations of each on sketch.