

MISSISSIPPI DEPARTMENT OF NATURAL RESOURCES

Bureau of Land and Water Resources

Southport Mall

P.O. Box 10631

Jackson, Mississippi 39209

WATER WELL DRILLERS LOG

Marion
P 67
8-5-86

copy
 noted

8-5 19 86 Hollinger Marion
 date well completed firm name county well located

LANDOWNER: Sidney Burch
Rt 1
Spring Cottage
 (mailing address)

description of formations encountered	from	to
<u>sand, gravel</u>	<u>0</u>	<u>70</u>
<u>chert</u>	<u>40</u>	<u>420</u>
<u>sand, gravel</u>	<u>420</u>	<u>500</u>
<u>chert</u>	<u>500</u>	<u>800</u>
<u>gook sand</u>	<u>800</u>	<u>920</u>
<u>fine sand</u>	<u>920</u>	<u>990</u>

WELL LOCATION:
 sec. 36 T. 20 N. R. 17 E. S. 1
1 1/2 miles N of SPRINGS
 (distance) (direction) (nearest town)

WELL PURPOSE:
 (home, irrigation, municipal, industrial)

WELL COMPLETION DATA:

(1) diameter (inches) 2"

(2) total depth (feet) 990

(3) static water level (feet) flow below above top of ground.

(4) casing puv 990
 (material) (depth)

(size) if telescope see back.

(5) screen 20 970
 (length) (depth to top)

2"
 (size) (material)

(6) pump NONE 50
 (HP) (yield gpm)

NONE
 (type power)

(7) electric log _____
 (yes or no)

_____ (organization running log)

(8) how well bottom plugged SAND
SHARK

DRILLERS REMARKS: Very
Good Flow


RECEIVED

DEC 17 1987

Department of Natural Resources
 Bureau of Land & Water Resources

If well telescopes please sketch and show depths.

GROUND LEVEL

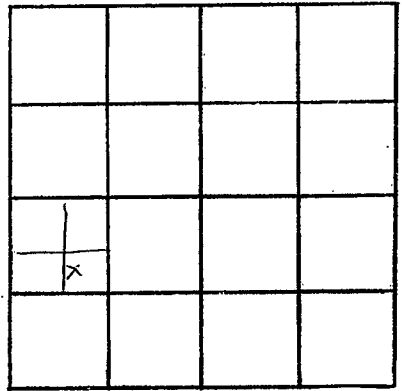

SECTION 36

Please indicate well location X.

ADDITIONAL INFORMATION

If more than one screen,
show locations of each on sketch.