

MISSISSIPPI DEPARTMENT OF NATURAL RESOURCES
Bureau of Land and Water Resources
 Southport Mall
 P.O. Box 10631
 Jackson, Mississippi 39209
WATER WELL DRILLERS LOG

Marion
P
2000

4-28- 19 82 Hollinger Marion
 date well completed firm name county well located

LANDOWNER: <u>Buford Cooper</u>	description of formations encountered	from	to
<u>Pine Burr, ms.</u>			
(mailing address)	<u>sand, gravel</u> <u>Chalk</u> <u>coarse sand</u>	<u>0</u> <u>30</u> <u>100</u>	<u>30</u> <u>100</u> <u>220</u>
WELL LOCATION:			
sec. <u>14</u> <u>T 20 N</u> <u>R 17 E</u> <u>S</u> <u>W</u> <u>3</u> miles <u>S</u> of <u>Huh</u> (distance) (direction) (nearest town)			
WELL PURPOSE:			
<u>(home irrigation, municipal, industrial)</u>			
WELL COMPLETION DATA:			
(1) diameter (inches) <u>2</u>			
(2) total depth (feet) <u>220</u>			
(3) static water level (feet) <u>50</u> <u>below</u> <u>above</u> top of ground.			
(4) casing <u>PVC</u> , <u>220</u> , (material) (depth) _____ if telescope see back. (size)			
(5) screen <u>10</u> , <u>210</u> (length) (depth to top) <u>2</u> , <u>PVC</u> (size) (material)			
(6) pump <u>1</u> , <u>8</u> (HP) (yield gpm) _____ (type power)			
(7) electric log _____ (yes or no) _____ (organization running log)			
(8) how well bottom plugged <u>sand</u> <u>shack</u>			

copy

DEPT. OF NATURAL RESOURCES
 BUREAU OF LAND & WATER RESOURCES


NOV 17 1982

RECEIVED

DRILLERS REMARKS: good

If well telescopes please sketch and show depths.

GROUND LEVEL

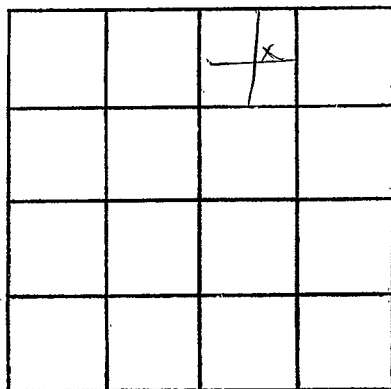

SECTION 14

Please indicate well location X.

ADDITIONAL INFORMATION

If more than one screen, show locations of each on sketch.