

MISSISSIPPI DEPARTMENT OF NATURAL RESOURCES

Bureau of Land and Water Resources

Southport Mall

P.O. Box 10631

Jackson, Mississippi 39209

WATER WELL DRILLERS LOG

<i>Marion</i>
<i>P</i>
<i>2001</i>

April 23 19*83* *Reeves Well Serv* *Marion*
 date well completed firm name county well located

LANDOWNER:

James Peak
Columbia
 (mailing address)

WELL LOCATION:

sec. *10* T. *2* N. R. *17* W.
11 miles *S-SE* of *Columbia*
 (distance) (direction) (nearest town)

WELL PURPOSE:

home
 (home, irrigation, municipal, industrial)

WELL COMPLETION DATA:

- (1) diameter (inches) *4"*
 (2) total depth (feet) *220'*
 (3) static water level (feet) *60'* below
 top of ground.
 (4) casing *plastic* *Bottom*
 (material) (depth)
 (size) if telescope see back.
 (5) screen *10'* *210'*
 (length) (depth to top)
 (size) *4"* *plastic*
 (material)
 (6) pump *3hp sub* *12*
 (HP) (yield gpm)
Elect.
 (type power)
 (7) electric log *no*
 (yes or no)

(organization running log)

- (8) how well bottom plugged *partially*

DRILLERS REMARKS:

description of formations encountered

from

to

<i>clay</i>	<i>0</i>	<i>18</i>
<i>sand & gravel</i>	<i>18</i>	<i>45</i>
<i>blue clay</i>	<i>45</i>	<i>100</i>
<i>coarse sand</i>	<i>100</i>	<i>220</i>
<i>pea gravel</i>	<i>200</i>	<i>220</i>
<i>sand</i>		


DEPT. OF NATURAL RESOURCES
 BUREAU OF LAND & WATER RESOURCES

JUN 17 1983

RECEIVED

If well telescopes please
sketch and show depths.

GROUND LEVEL

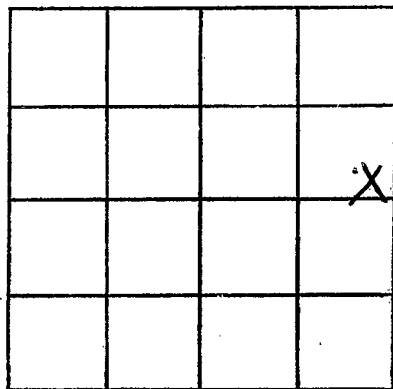

SECTION 10

Please indicate well location X.

ADDITIONAL INFORMATION

If more than one screen,
show locations of each on sketch.