

MISSISSIPPI DEPARTMENT OF NATURAL RESOURCES

Bureau of Land and Water Resources

Southport Mall

P.O. Box 10631

Jackson, Mississippi 39209

Marion  
P  
2003

WATER WELL DRILLERS LOG

**TOM GRIFFITH**  
**PLUMBING & WELL SERVICE, INC.**

320 MAYSON AVE.  
COLUMBIA, MS 39429

Marion  
county well located

8/26/1983  
date well completed

LANDOWNER: Helen Jefferson  
Rt. 5, Box 299  
Columbia, MS 39429  
(mailing address)

description of formations encountered

from

to

WELL LOCATION:  
sec. 5 T 20 N R 17 E  
6 miles S of Columbia  
(distance) (direction) (nearest town)

Chalk 11' 12'  
Sand 12' 35'  
Gravel 35' 65'

WELL PURPOSE: home  
(home, irrigation, municipal, industrial)

- WELL COMPLETION DATA:
- (1) diameter (inches) 2"
  - (2) total depth (feet) 65'
  - (3) static water level (feet) 15' below above top of ground.
  - (4) casing PVC, 55',  
(material) (depth)  
N/A if telescope see back.  
(size)
  - (5) screen 10', 58'  
(length) (depth to top)  
2", PVC  
(size) (material)
  - (6) pump 1 (HP) (yield gpm)  
Electric  
(type power)
  - (7) electric log none  
(yes or no)  
N/A  
(organization running log)
  - (8) how well bottom plugged BWW


DRILLERS REMARKS:

DEPT. OF NATURAL RESOURCES  
BUREAU OF LAND AND WATER RESOURCES

SEP - 1 1983  
**RECEIVED**

If well telescopes please sketch and show depths.

GROUND LEVEL

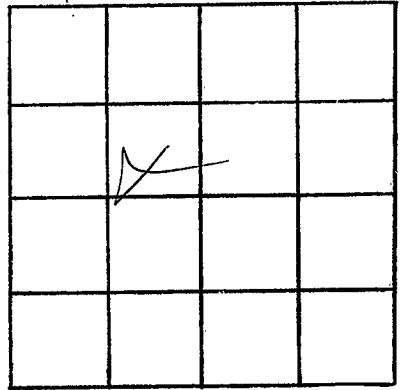

SECTION \_\_\_\_\_

Please indicate well location X.

ADDITIONAL INFORMATION

If more than one screen,  
show locations of each on sketch.