

MISSISSIPPI DEPARTMENT OF NATURAL RESOURCES

Bureau of Land and Water Resources

Southport Mall

P.O. Box 10631

Jackson, Mississippi 39209

WATER WELL DRILLERS LOG

TOM GRIFFITH

PLUMBING & WELL SERVICE, INC.

Marion

Marion
P
2004

12-8-83
date well completed

510 HAYSON AVE.
COLUMBIA, MISSISSIPPI 39423

county well located

LANDOWNER: Lewis Hibley

description of formations encountered

from

to

774

Chalk Gravel

1 20'

Columbia, MS
(mailing address)

Chalk

20' 70'

WELL LOCATION:

sec. 13 T. 2 (N) S

R. 17 E

13 miles S of Columbia
(distance) (direction) (nearest town)

Sand

70' 130'

Chalk

130' 190'

Sand

190' 225'

WELL PURPOSE:

Drain
(home, irrigation, municipal, industrial)

WELL COMPLETION DATA:

- (1) diameter (inches) 2"
- (2) total depth (feet) 225'
- (3) static water level (feet) 140 below above top of ground.
- (4) casing PVC, 205'
(material) (depth)
N/A if telescope see back.
(size)
- (5) screen 20', 205'
(length) (depth to top)
2", PVC
(size) (material)
- (6) pump 2 10
(HP) (yield gpm)
Elec.
(type power)
- (7) electric log none
(yes or no)
N/A
(organization running log)
- (8) how well bottom plugged BWU

DEPT. OF NATURAL RESOURCES
BUREAU OF LAND & WATER RESOURCES


DRILLERS REMARKS:

MAR -9 1983

RECEIVED

If well telescopes please sketch and show depths.

GROUND LEVEL

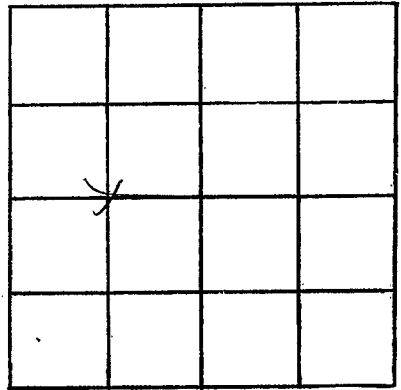

SECTION 13

Please indicate well location X.

ADDITIONAL INFORMATION

If more than one screen,
show locations of each on sketch.