

Marion  
 P  
 2005

MISSISSIPPI  
 BOARD OF WATER COMMISSIONERS  
 416 North State Street  
 Jackson, Mississippi 39201

WATER WELL DRILLERS LOG

3/21/1984  
 date well completed

PLUMBING & WELL SERVICE, INC.

320 MAYSON AVE.  
 COLUMBIA, MS 39429

Marion  
 county well located

LANDOWNER: H. Y. Johnson

170.6, Box 130

Columbia, MS 39429  
 (mailing address)

description of formations  
 encountered

from to

Clay	1'	135'
Sand	135'	145'
Clay	145'	170'
Sand	170'	220'

WELL LOCATION:

sec. 1 T 20 N R 17 E  
 S W  
 5 miles E of Pineburg  
 (distance) (direction) (nearest town)

WELL PURPOSE: Home  
 (home, irrigation, municipal, industrial)

WELL COMPLETION DATA:

- (1) diameter (inches) 4"
- (2) total depth (feet) 220'
- (3) static water level (feet) 90' below top of ground.
- (4) casing PVC, 200' (material) (depth)  
 N/A (size) if telescope see back.
- (5) screen 20' (length) 200' (depth to top)  
 4" (size) PVC (material)
- (6) pump 3/4 (HP) 12 (yield gpm)  
 Elec. (type power)
- (7) electric log N/A (yes or no)  
 N/A (organization running log)
- (8) how well bottom plugged 130V

DEPT. OF NATURAL RESOURCES  
 BUREAU OF LAND & WATER RESOURCES


APR 19 1984

DRILLERS REMARKS:

RECEIVED

If well telescopes please sketch and show depths.

GROUND LEVEL

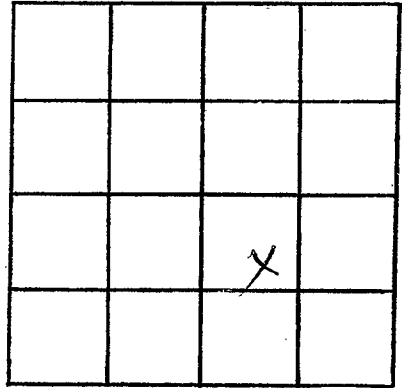

SECTION 1

Please indicate well location X.

ADDITIONAL INFORMATION

If more than one screen,  
show locations of each on sketch.