

Marion  
P  
2007

MISSISSIPPI  
BOARD OF WATER COMMISSIONERS  
416 North State Street  
Jackson, Mississippi 39201

WATER WELL DRILLERS LOG

PLUMBING & WELL SERVICE, Marion

2-7-84  
date well completed

320 MAYSON AVE.  
COLUMBIA, MS 39429

county well located

LANDOWNER: Annie Mae Watson

Pl. 6, Box 32

Columbia, MS 39429  
(mailing address)

description of formations encountered

from to

Clay + Gravel

1' 20'

Sand + fine Gravel

20' 70'

WELL LOCATION:

sec. 20 T 20 N R 17 E  
2 miles SE of Hub, MS  
(distance) (direction) (nearest town)

WELL PURPOSE: Home  
(home, irrigation, municipal, industrial)

WELL COMPLETION DATA:

- (1) diameter (inches) 2"
- (2) total depth (feet) 70'
- (3) static water level (feet) 30' below top of ground.
- (4) casing PVC, 600' (material) (depth)  
NA (size) if telescope see back.
- (5) screen 10' (length) 70' 60' (depth to top)  
2" (size) PVC (material)
- (6) pump 1 (HP) 10 (yield gpm)  
Elec. (type power)
- (7) electric log NA (yes or no)  
NA (organization running log)
- (8) how well bottom plugged 1300V

DEPT. OF NATURAL RESOURCES  
BUREAU OF LAND & WATER RESOURCES


APR 19 1984

DRILLERS REMARKS:

RECEIVED

If well telescopes please sketch and show depths.

GROUND LEVEL

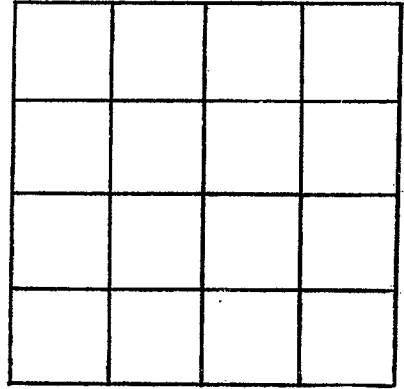

SECTION \_\_\_\_\_

Please indicate well location X.

ADDITIONAL INFORMATION

If more than one screen, show locations of each on sketch.