

MISSISSIPPI DEPARTMENT OF NATURAL RESOURCES
 Bureau of Land and Water Resources
 Southport Mall
 P.O. Box 10631
 Jackson, Mississippi 39209
WATER WELL DRILLERS LOG

Marion
P
2008

11-3
date well completed

1984 Hollinger
firm name

Marion
county well located

LANDOWNER: Shelby Davis

description of formations encountered

from to

Spring Cottage

sand, clay	0	10
sandy, gravel	10	20
fine gravel,	20	40

(mailing address)

WELL LOCATION:

sec. 31 T 2 (N) R 17 E
 S W
 1/2 miles SE of Spring Cottage
 (distance) (direction) (nearest town)

WELL PURPOSE: Camp
 (home, irrigation, municipal, industrial)

WELL COMPLETION DATA:

- (1) diameter (inches) 2"
- (2) total depth (feet) 40
- (3) static water level (feet) 12 below above top of ground.
- (4) casing PVC (material), (depth)

if telescope see back.
 (size)

- (5) screen 5 35
 (length) (depth to top)

2" PVC
 (size) (material)

- (6) pump 1/2 8
 (HP) (yield gpm)

elect
 (type power)

- (7) electric log (yes or no)

(organization running log)

- (8) how well bottom plugged sand silt/clay

DRILLERS REMARKS: Very good well


DEPT. OF NATURAL RESOURCES
 BUREAU OF LAND & WATER RESOURCES

NOV 20 1984

RECEIVED

If well telescopes please sketch and show depths.

GROUND LEVEL

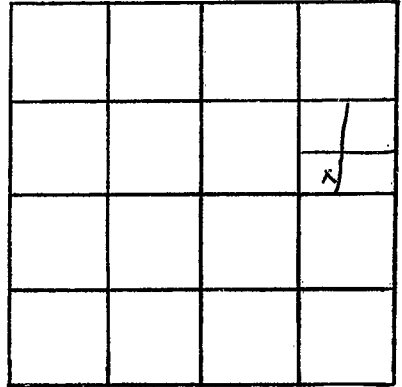

SECTION 31

Please indicate well location X.

ADDITIONAL INFORMATION

If more than one screen,
show locations of each on sketch.