

MARION
 P
 2009

MISSISSIPPI
 BOARD OF WATER COMMISSIONERS
 416 North State Street
 Jackson, Mississippi 39201

WATER WELL DRILLERS LOG

11-23 1985 ^{Tom Griffith} Water Well Marion
 date well completed firm name county well located

LANDOWNER: Charles Burkhalter
 Rt. 2 Box 225
 Columbia, MS 39429
 (mailing address)

description of formations encountered	from	to
Clay Band	0	185
	185	205

WELL LOCATION:
 sec. 1 T. 2 (N) R. 12 E
 S W
 10 miles SE of Columbia
 (distance) (direction) (nearest town)

WELL PURPOSE: Home
 (home, irrigation, municipal, industrial)


- WELL COMPLETION DATA:
- (1) diameter (inches) 4"
 - (2) total depth (feet) 190 205
 - (3) static water level (feet) 115 below above top of ground.
 - (4) casing PVC, 190 (material) (depth)
 NA (size) if telescope see back.
 - (5) screen 15, 190 (length) (depth to top)
 4" PVC (size) (material)
 - (6) pump 3/4, 10 (HP) (yield gpm)
 Electric (type power)
 - (7) electric log NO (yes or no)
 NA (organization running log)
 - (8) how well bottom plugged BWV

RECEIVED
 FEB - 7 1986

DRILLERS REMARKS:

If well telescopes please sketch and show depths.

GROUND LEVEL

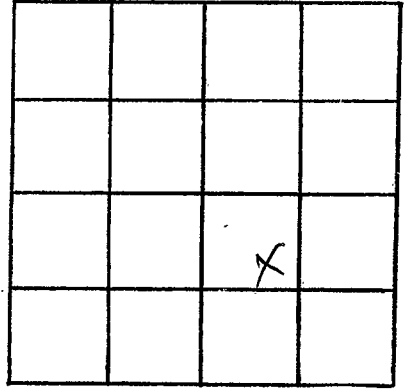

SECTION _____

Please indicate well location X.

ADDITIONAL INFORMATION

If more than one screen,
show locations of each on sketch.