

MARION
P 2013

MISSISSIPPI DEPARTMENT OF NATURAL RESOURCES
Bureau of Land and Water Resources
Southport Mall
P.O. Box 10631
Jackson, Mississippi 39209
WATER WELL DRILLERS LOG

3-5-87 19 Louis Batson marion
date well completed firm name county well located

LANDOWNER: Herman Hibley
Rt. 2
Columbia, ms. 39429
(mailing address)

description of formations encountered	from	to
Sand	1	10
Chalk	10	273
Sand	273	318

WELL LOCATION:
sec. 15 T 2 S R 17 E
19 miles S of Columbia
(distance) (direction) (nearest town)

WELL PURPOSE:
(home, irrigation, municipal, industrial)

WELL COMPLETION DATA:

- (1) diameter (inches) 2"
- (2) total depth (feet) 318
- (3) static water level (feet) 200 below above top of ground.
- (4) casing 2" Pvc 318
(material) (depth)
2" If telescope see back.
(size)
- (5) screen 10 308
(length) (depth to top)
2" Pvc
(size) (material)
- (6) pump (HP) (yield gpm)
(type power)
- (7) electric log (yes or no)
(organization running log)
- (8) how well bottom plugged

DRILLERS REMARKS:

RECEIVED
MAR 30 1987

Department of Natural Resources
Bureau of Land & Water Resources


If well telescopes please sketch and show depths.

GROUND LEVEL

318 ft.

10
Screen
back wash
valve

If more than one screen, show locations of each on sketch.

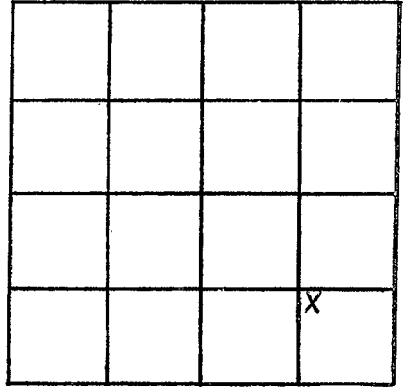

SECTION 15

Please indicate well location X.

ADDITIONAL INFORMATION

A series of horizontal lines provided for additional information.