

**MISSISSIPPI DEPARTMENT OF NATURAL RESOURCES**  
 Bureau of Land and Water Resources  
 Southport Mall  
 P.O. Box 10631  
 Jackson, Mississippi 39209  
**WATER WELL DRILLERS LOG**

Marion
P 2015
4-25-81

4/25 1981 Dumaway's Plumbing Marion  
 date well completed firm name county well located


LANDOWNER: C. J. Auchild  
Route 2 Box 238  
Columbia, Mo. 39429  
 (mailing address)

description of formations encountered	from	to
	Top	0
Clay	3 1/2	24 ft.
Sand	24	36 ft.
Shale	36	120 ft.
Sand	120	133 ft.
Chalky shale	133	260 ft.
Sand	260	330 ft.

WELL LOCATION:  
 sec. 24 T-2 N R-17 E  
1 1/2 miles SE of Pinebur  
 (distance) (direction) (nearest town)

WELL PURPOSE:  
 (home) Irrigation, municipal, industrial


- WELL COMPLETION DATA:
- (1) diameter (inches) 2 inch
- (2) total depth (feet) 330 ft.
- (3) static water level (feet) 200 below above top of ground.
- (4) casing PVC 330 ft.  
 (material) (depth)
- \_\_\_\_\_ if telescope see back.  
 (size)
- (5) screen 20 ft. 310 ft.  
 (length) (depth to top)
- 2 inch PVC  
 (size) (material)
- (6) pump NONE- SET ON  
 (HP) (yield gpm)
- \_\_\_\_\_ (type power)
- (7) electric log No  
 (yes or no)
- \_\_\_\_\_ (organization running log)
- (8) how well bottom plugged sand  
shale

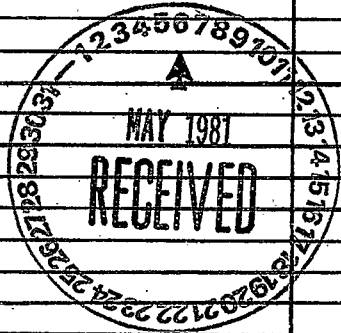

DRILLERS REMARKS: \_\_\_\_\_

If well telescopes please sketch and show depths.

GROUND LEVEL

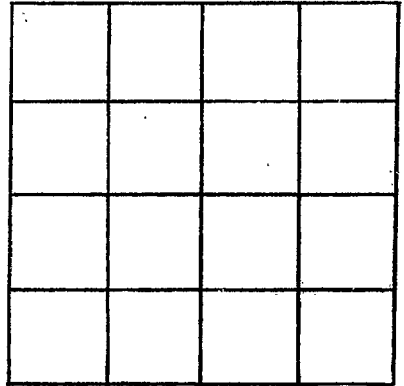

SECTION \_\_\_\_\_

Please indicate well location X.

ADDITIONAL INFORMATION

If more than one screen,  
show locations of each on sketch.