

Marion  
P 2016  
4-10-81

MISSISSIPPI  
BOARD OF WATER COMMISSIONERS  
416 North State Street  
Jackson, Mississippi 39201

WATER WELL DRILLERS LOG

4-10 1981 Hollingsworth Marion  
date well completed firm name county well located

LANDOWNER: Marion Little  
Rt 2 Columbia  
(mailing address)

description of formations encountered	from	to
sand, gravel	0	32
CHALK	32	200
COARSE sand,	200	240

WELL LOCATION:  
sec. 24 T 2 N S R 17 E W  
3 miles NE of PINEBUR  
(distance) (direction) (nearest town)

WELL PURPOSE: Home  
(home, irrigation, municipal, industrial)

- WELL COMPLETION DATA:
- (1) diameter (inches) 2
  - (2) total depth (feet) 240
  - (3) static water level (feet) 70 <sup>below</sup> <sub>above</sub> top of ground.
  - (4) casing PVC (material) (depth)  
(size) If telescope see back.
  - (5) screen 10 230 (length) (depth to top)  
2 (size) PVC (material)
  - (6) pump 1 9 (HP) (yield gpm)  
elect (type power)
  - (7) electric log                      (yes or no)  
(organization running log)
  - (8) how well bottom plugged sand  
SHARK

DEPT. OF NATURAL RESOURCES  
BUREAU OF LAND & WATER RESOURCES


MAY 13 1981

DRILLERS REMARKS: Very good well

RECEIVED

If well telescopes please sketch and show depths.

GROUND LEVEL

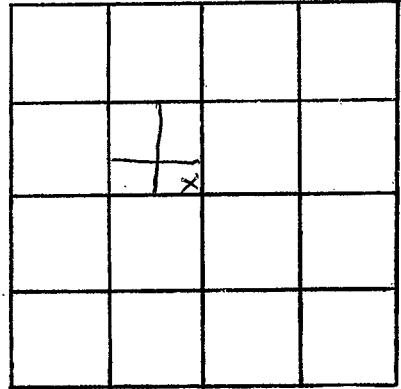

SECTION 24

Please indicate well location X.

ADDITIONAL INFORMATION

If more than one screen, show locations of each on sketch.