

MARION
P 2017
May 10, 1979

MISSISSIPPI
BOARD OF WATER COMMISSIONERS
416 North State Street
Jackson, Mississippi 39201

WATER WELL DRILLERS LOG

TOM GRIFFITH

PLUMBING & WELL SERVICE, INC.

Marion

May 10 1979
date well completed

320 MAYSON AVE.
COLUMBIA, MS 39209

county well located

LANDOWNER:

Mr. Bill Hale

description of formations encountered

from to

Rt. 2 Box 255A
Columbia, Miss (mailing address)

Top Soil	0	1
Clay	1	19
Gravel	19	39
Gravel	39	42
Sand	47	86
Clay	86	117
Sand	122	142

WELL LOCATION:

sec. 10 T 2 N R 17 E
S W
10 miles SE of Columbia
(distance) (direction) (nearest town)

WELL PURPOSE:

Flow
(home, irrigation, municipal, industrial)

WELL COMPLETION DATA:

- (1) diameter (inches) 4"
- (2) total depth (feet) 149 ft
- (3) static water level (feet) 50 ft below top of ground.
- (4) casing plastic, 129 ft (material) (depth)
4" (size) If telescope see back.
- (5) screen 20 ft, 129 ft (length) (depth to top)
4" (size) plastic (material)
- (6) pump 1/2 hp, 12 gals (HP) (yield gpm)
Electric (type power)
- (7) electric log No (yes or no)

(organization running log)

(8) how well bottom plugged
Back Wash Valve

DRILLERS REMARKS:


Miss. Board of Water Comm.

JUL 9 1979

RECEIVED

If well telescopes please sketch and show depths.

GROUND LEVEL

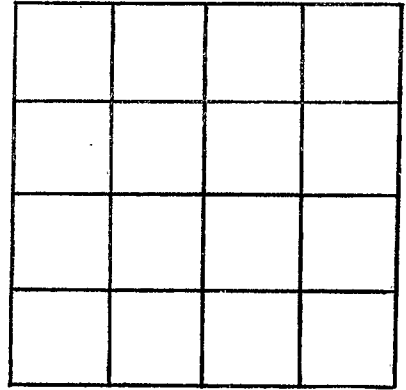

SECTION _____

Please indicate well location X.

ADDITIONAL INFORMATION

If more than one screen, show locations of each on sketch.