

MARION
 P 2019
 4-10-79

MISSISSIPPI
 BOARD OF WATER COMMISSIONERS
 416 North State Street
 Jackson, Mississippi 39201

WATER WELL DRILLERS LOG

4/10 1979 Hollingsworth Marion
 date well completed firm name county well located

LANDOWNER: Nate Culpeper
 Rt 2
 Columbia, MS
 (mailing address)

description of formations encountered	from	to
sand, gravel	0	38
CLAY	30	160
sand	160	200

WELL LOCATION:
 sec. 3 T. 2 (N) R. 17 E
 S W
 2 miles N of Pine Bluff
 (distance) (direction) (nearest town)

WELL PURPOSE:
 (home, irrigation, municipal, industrial)

WELL COMPLETION DATA:

(1) diameter (inches) 4"

(2) total depth (feet) 200

(3) static water level (feet) 38 below above top of ground.

(4) casing PVC, 180 (material) (depth)
 (size) if telescope see back.

(5) screen 10, 180 (length) (depth to top)
 4, PVC (size) (material)

(6) pump 1, 18 (HP) (yield gpm)
 elect (type power)

(7) electric log (yes or no)

(organization running log)

(8) how well bottom plugged sand SHANK

DRILLERS REMARKS: good well


Miss. Board of Water Comm.

MAY 14 1979

RECEIVED

If well telescopes please sketch and show depths.

GROUND LEVEL

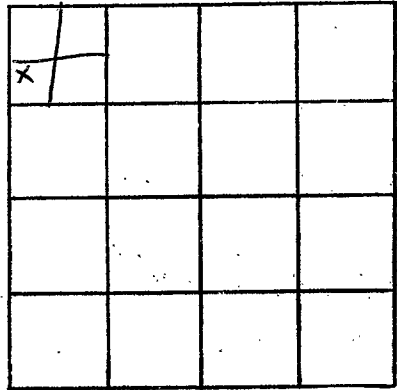

SECTION 3

Please indicate well location X.

ADDITIONAL INFORMATION

If more than one screen, show locations of each on sketch.