

MARION
 P 2020
 5-4-79

MISSISSIPPI
 BOARD OF WATER COMMISSIONERS
 416 North State Street
 Jackson, Mississippi 39201

WATER WELL DRILLERS LOG

5/4 1979 Hollinger Marion
 date well completed firm name county well located

LANDOWNER	description of formations encountered	from	to
Thomas Culp Rt 2 Columbia, MS (mailing address)	CHARIC SAND & GRAVEL	0 140	140 200

WELL LOCATION:
 sec. 3 T. 20 N. R. 17 E.
 S (W)
 2 miles N of Pine Bluff
 (distance) (direction) (nearest town)

WELL PURPOSE:
 (home, irrigation, municipal, industrial)

- WELL COMPLETION DATA:
- (1) diameter (inches) 2"
 - (2) total depth (feet) 200
 - (3) static water level (feet) 45 below top of ground.
 - (4) casing PVC 190 (material) (depth)
 - (size) if telescope see back.
 - (5) screen 10 190 (length) (depth to top)
 - 2 PVC (size) (material)
 - (6) pump 1 9 (HP) (yield gpm)
 - elect (type power)
 - (7) electric log (yes or no)
 - (organization running log)

(8) how well bottom plugged sand CHARIC

DRILLERS REMARKS: good well


Miss. Board of Water Comm

MAY 14 1979

RECEIVED

If well telescopes please sketch and show depths.

GROUND LEVEL

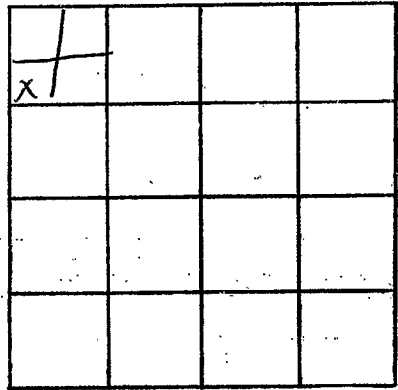

SECTION 3

Please indicate well location X.

ADDITIONAL INFORMATION

Lined area for additional information.

If more than one screen, show locations of each on sketch.