

MARION  
 P 2021  
 9-21-78

MISSISSIPPI  
 BOARD OF WATER COMMISSIONERS  
 416 North State Street  
 Jackson, Mississippi 39201

WATER WELL DRILLERS LOG

9/21 1978 Hollinger Well 5. Marion county well located  
 date well completed firm name

LANDOWNER:	description of formations encountered	from	to
John Lawrence RT 4 Sumberton MS (mailing address)			

WELL LOCATION:  
 sec. 24 T 2 N S R 17 E W  
 5 miles W of Sumberton  
 (distance) (direction) (nearest town)


WELL PURPOSE: Home  
 (home, irrigation, municipal, industrial)

- WELL COMPLETION DATA:
- (1) diameter (inches) 2"
  - (2) total depth (feet) 170
  - (3) static water level (feet) 110 below top of ground.
  - (4) casing PVC, 160 (material) (depth)  
 (size) if telescope see back.
  - (5) screen 10 ft, 160 (length) (depth to top)  
 (size) (material)
  - (6) pump 1 1/2 (HP) 6 (yield gpm)  
 elect (type power)
  - (7) electric log (yes or no)

(organization running log)

well bottom plugged sand  
 DRILLER SHARK

REMARKS: Very Good

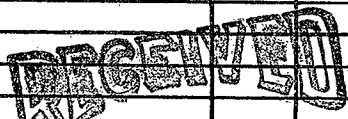


OCT 12 1978

MISS. BD. OF WATER COMMISSIONERS

If well telescopes please sketch and show depths.

GROUND LEVEL

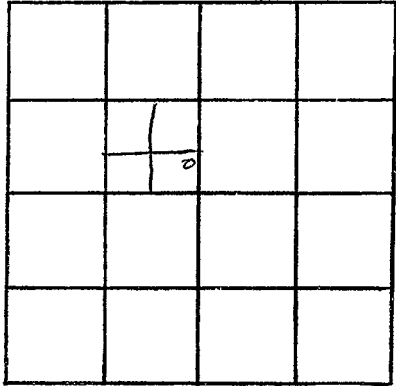

SECTION 24

Please indicate well location X.

ADDITIONAL INFORMATION

If more than one screen,  
show locations of each on sketch.