

MARION,  
 P 2022  
 6/1/78

MISSISSIPPI  
 BOARD OF WATER COMMISSIONERS  
 416 North State Street  
 Jackson, Mississippi 39201

WATER WELL DRILLERS LOG

6/1 1978 Hollinger Well Service MARION  
 date well completed firm name county well located

LANDOWNER: Jimmy Lavin  
RT 2 Box 239  
Columbia Ms  
 (mailing address)

description of formations encountered	from	to
Sand, gravel, clay	0	60
clay & k	60	340
Sand	340	380

WELL LOCATION:  
 sec. 14 T 2 (N) R 17 E  
1 miles E of Pineland  
 (distance) (direction) (nearest town)

WELL PURPOSE: Home  
 (home, irrigation, municipal, industrial)

- WELL COMPLETION DATA:
- (1) diameter (inches) 3"
  - (2) total depth (feet) 380
  - (3) static water level (feet) 202 <sup>below</sup> <sub>above</sub> top of ground.
  - (4) casing PVC, 365,  
 (material) (depth)  
 (size) if telescope see back.
  - (5) screen 15, 365  
 (length) (depth to top)  
3, PVC  
 (size) (material)
  - (6) pump 1/2, 7  
 (HP) (yield gpm)  
elect  
 (type power)
  - (7) electric log             
 (yes or no)


(organization running log)  
 (8) how well bottom plugged sand  
shale k

DRILLERS REMARKS: Good well

RECEIVED  
 JUN 23 1978

If well telescopes please sketch and show depths.

GROUND LEVEL

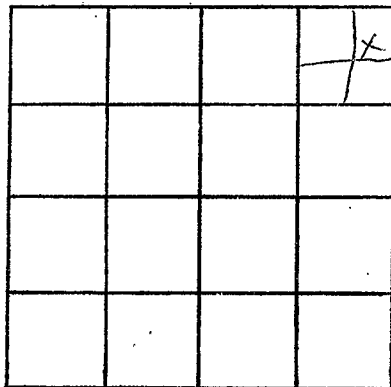

SECTION 14

Please indicate well location X.

ADDITIONAL INFORMATION

If more than one screen,  
show locations of each on sketch.