

MARTON

P 2023

4-6-78

MISSISSIPPI
 BOARD OF WATER COMMISSIONERS
 416 North State Street
 Jackson, Mississippi 39201

WATER WELL DRILLERS LOG

4/6 date well completed

1978 Hollinger Wells firm name

MARION county well located

LANDOWNER: Hershel Kennedy
Rt 2
Columbia, Ms
 (mailing address)

description of formations encountered	depth	
	from	to
CHALK, GRAVEL	0	20
CHALK	20	100
SAND, PEAT GRAVEL	100	140

WELL LOCATION:
 sec 9 T 20 N R 17 E
1 1/2 miles NW of Pinbure
 (distance) (direction) (nearest town)

WELL PURPOSE: Home
 (home, irrigation, municipal, industrial)

- WELL COMPLETION DATA:
- (1) diameter (inches) 2"
 - (2) total depth (feet) 140
 - (3) static water level (feet) 10 ^{below} _{above} top of ground.
 - (4) casing PVC 140
 (material) (depth)
 (size) if telescope see back.
 - (5) screen 5 135
 (length) (depth to top)
2" PVC
 (size) (material)
 - (6) pump 1/2 12
 (HP) (yield gpm)
elect
 (type power)
 - (7) electric log
 (yes or no)
 (organization running log)

(8) how well bottom plugged SAND
SHARK


DRILLERS REMARKS: good well

RECEIVED
 MAY 3 - 1978

MISS. BD. OF WATER COMM

If well telescopes please sketch and show depths.

GROUND LEVEL

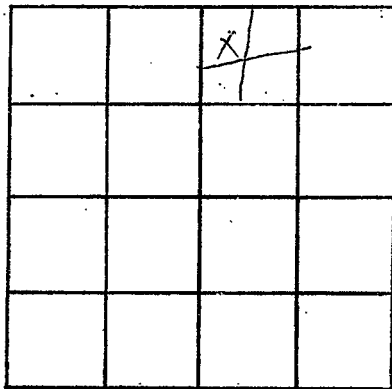

SECTION 9

Please indicate well location X.

ADDITIONAL INFORMATION

If more than one screen,
show locations of each on sketch.